

## Designation: 1J-51-69

Date Destroyed:

Date Revised:

GPS #:

OCS Index Map: Q10-07


Page/Grid: 857/B-2

City / Location: Huntington Beach

Line #/SSN: 400/1030

Established By: OCS 1969

Monument Type: Orange County Surveyor's 3 3/4"  
Aluminum Disk

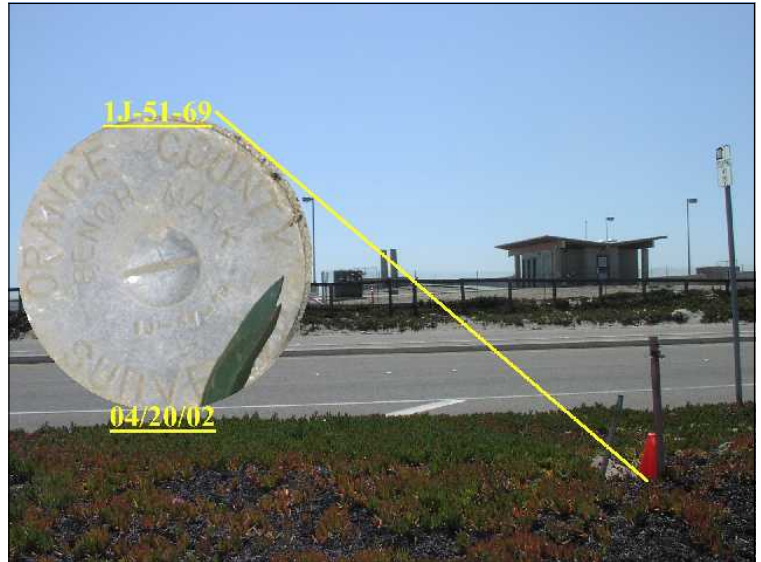

NAVD88 (ft)	NGVD29 (ft)	Year Leveled
8.220	5.804	2005
8.307	5.866	1989

For Reconnaissance Only!	
Latitude (30' +/-)	Longitude (30' +/-)
33 42 26.93	118 03 32.25

### Description:

DESCRIBED BY OCS 2002 - FOUND 3 3/4" OCS ALUMINUM BENCHMARK DISK STAMPED "1J-51-69", SET IN THE TOP OF A CONCRETE POST. MONUMENT IS LOCATED ALONG THE NORTHEASTERLY SIDE OF PACIFIC COAST HIGHWAY, 0.3 MILES SOUTHEASTERLY OF THE CENTERLINE OF WARNER AVENUE, 49 FT. NORTHEASTERLY OF THE MEDIAN ALONG PCH AND BETWEEN TWO STEEL WITNESS POSTS. MONUMENT IS SET 0.3 FT. BELOW GROUND.

