

Designation: 1J-78-04

Date Destroyed:

Date Revised: 4/8/2015

GPS #:

OCS Index Map: Q11-19


Page/Grid: 888/H-6

City / Location: Newport Beach

Line #/SSN: 400/1330

Established By: OCS 2004

Monument Type: Orange County Surveyor's 3 3/4"
Aluminum Disk

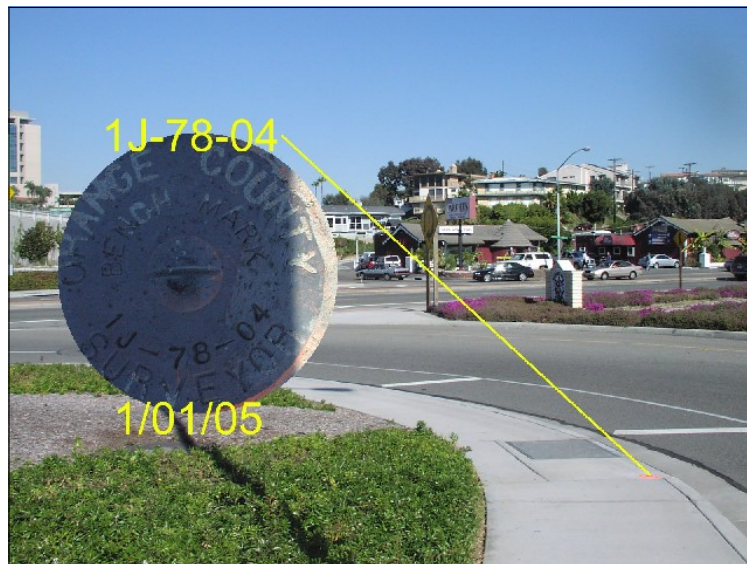

NAVD88 (ft)	NGVD29 (ft)	Year Leveled
11.948	9.551	2015
11.930	9.536	2005

For Reconnaissance Only!	
Latitude (30' +/-)	Longitude (30' +/-)
33 37 15.15	117 55 43.66

Description:

DESCRIBED BY OCS 2005 - FOUND 3 3/4" OCS ALUMINUM BENCHMARK DISK STAMPED "1J-78-04", SET IN THE SOUTHERLY CORNER OF A CURVED 4 FT. BY 8 FT. CONCRETE CATCH BASIN. MONUMENT IS LOCATED IN THE SOUTHERLY PORTION OF THE INTERSECTION OF PACIFIC COAST HIGHWAY AND NEWPORT BOULEVARD, 125 FT. SOUTHWESTERLY OF THE CENTERLINE OF PCH AND 180 FT. SOUTHERLY OF THE CENTERLINE OF NEWPORT BOULEVARD ALONG THE WESTERLY SIDE OF THE SOUTHBOUND PCH TO NORTHBOUND NEWPORT BOULEVARD ON-RAMP. MONUMENT IS SET LEVEL WITH THE TOP OF THE CURB.

