

### Designation: 1L-60-82

Date Destroyed:

Date Revised:

GPS #:

OCS Index Map: Q07-05


Page/Grid: 769/G-4

City / Location: Orange

Line #/SSN: 161/0330

Established By: OCS 1982

Monument Type: Orange County Surveyor's 3 3/4"  
Aluminum Disk

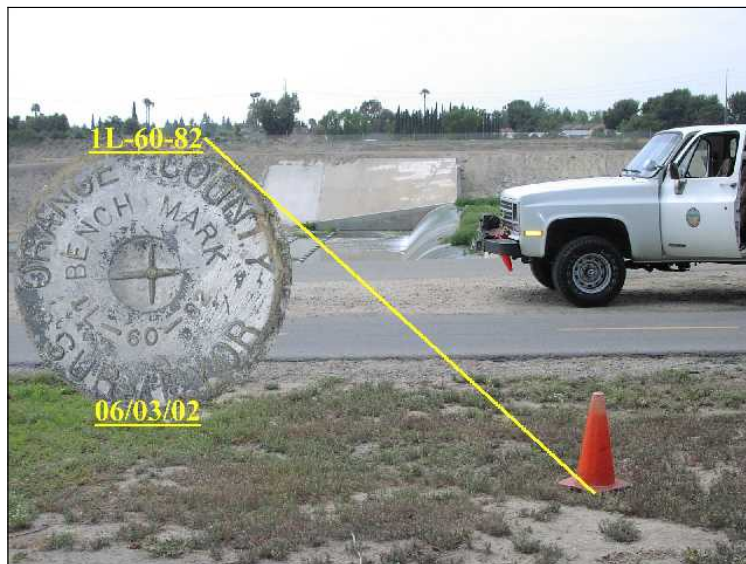

NAVD88 (ft)	NGVD29 (ft)	Year Leveled
222.011	219.598	2006
222.108	219.707	1990

For Reconnaissance Only!	
Latitude (30' +/-)	Longitude (30' +/-)
33 50 23.8	117 51 29.3

### Description:

DESCRIBED BY OCS 2002 - FOUND 3 3/4" OCS ALUMINUM BENCHMARK DISK STAMPED "1L-60-82", SET IN THE TOP OF A 6 IN. BY 6 IN. CONCRETE POST. MONUMENT IS LOCATED ALONG THE SANTA ANA RIVER SOUTHEASTERLY LEVEE, 0.4 MILES NORTHERLY ALONG THE BICYCLE TRAIL FROM THE CENTERLINE OF LINCOLN AVENUE, 16.5 FT. SOUTHEASTERLY OF THE CENTERLINE OF THE BICYCLE TRAIL AND DIRECTLY ON LINE WITH A LARGE CONCRETE DROP STRUCTURE SPANNING THE RIVER. MONUMENT IS SET 0.2 FT. UP FROM GROUND.

