

Designation: 1L-93-89

Date Destroyed:

Date Revised:

GPS #:

OCS Index Map: Q08-02


Page/Grid: 741/E-6

City / Location: Yorba Linda

Line #/SSN: 403/0990

Established By: OCS 1989

Monument Type: Orange County Surveyor's 3 3/4"
Aluminum Disk

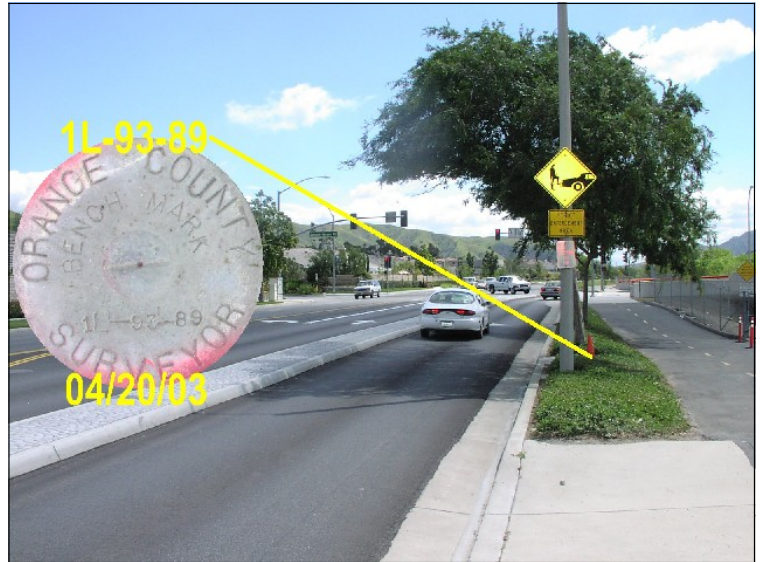

NAVD88 (ft)	NGVD29 (ft)	Year Leveled
386.469	384.058	1987

For Reconnaissance Only!	
Latitude (30' +/-)	Longitude (30' +/-)
33 52 25.18	117 42 49.51

Description:

DESCRIBED BY OCS 2003 - FOUND 3 3/4" OCS ALUMINUM BENCHMARK DISK STAMPED "1L-93-89", SET IN THE SOUTHEASTERLY CORNER OF A 4 FT. BY 4.5 FT. CONCRETE CATCH BASIN. MONUMENT IS LOCATED IN THE SOUTHWESTERLY CORNER OF THE INTERSECTION OF GYPSUM CANYON ROAD AND LA PALMA AVENUE, 18 FT. SOUTHERLY OF A 2 FT. WIDE CONCRETE MEDIAN ALONG EAST BOUND LA PALMA AND 144 FT. WESTERLY OF THE WEST SOUTH/WEST CURB RETURN. MONUMENT IS SET LEVEL WITH THE SIDEWALK.

