

Designation: 1L-99-91

Date Destroyed:

Date Revised:

GPS #:

OCS Index Map: Q11-14


Page/Grid: 888/E-5

City / Location: Newport Beach

Line #/SSN: 400/0750

Established By: OCS 1991

Monument Type: Orange County Surveyor's 3 3/4"
Aluminum Disk

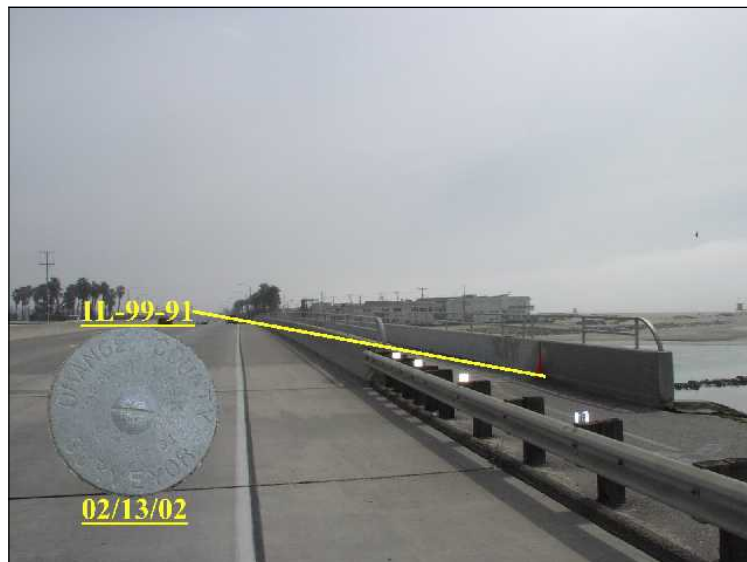

NAVD88 (ft)	NGVD29 (ft)	Year Leveled
24.742	22.334	2005
24.810	22.382	1992

For Reconnaissance Only!	
Latitude (30' +/-)	Longitude (30' +/-)
33 37 52.94	117 57 29.52

Description:

DESCRIBED BY OCS 2002 - FOUND 3 3/4" OCS ALUMINUM BENCHMARK DISK STAMPED "1L-99-91", SET IN THE WEST END OF A CONCRETE BRIDGE ABUTMENT. MONUMENT IS LOCATED IN THE NORTHWEST CORNER OF THE INTERSECTION OF PACIFIC COAST HIGHWAY AND THE SANTA ANA RIVER CROSSING, 52 FT. WESTERLY OF THE CENTERLINE OF PCH AND AT THE WESTERLY END OF THE NORTHERLY BRIDGE ABUTMENT. MONUMENT IS SET LEVEL WITH THE BIKE TRAIL.

