

VERTICAL CONTROL DATA SHEET O.C.S. 1995 ADJUSTMENT



Designation: 2C-103-76

Date Destroyed:

Date Revised:

GPS #:


OCS Index Map: Q02-12 Page/Grid: 709/C-7 City / Location: Brea

Line #/SSN: 253/0130 Established By: OCS 1976

Monument Type: Orange County Surveyor's 3 3/4"

Aluminum Disk

NAVD88 (ft)	NGVD29 (ft)	Year Leveled
375.220	372.804	2006
375.309	372.895	1990

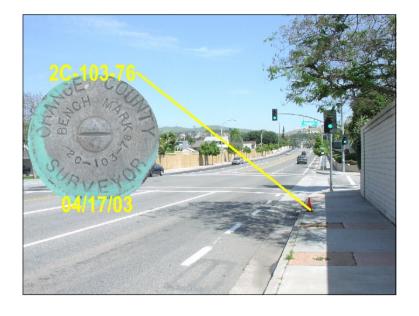

For Reconnaisance Only!		
Latitude (30' +/-)	Longitude (30' +/-)	
33 55 19.49	117 52 57.86	

Description:

DESCRIBED BY OCS 2003 - FOUND 3 3\4" OCS ALUMINUM BENCHMARK DISK STAMPED "2C-103-76", SET IN THE SOUTHEASTERLY CORNER OF A 1.5 FT. BY 8 FT. CONCRETE CATCH BASIN. MONUMENT IS LOCATED IN THE SOUTHEASTERLY CORNER OF THE INTERSECTION OF AVOCADO STREET AND STATE COLLEGE BOULEVARD, 33 FT. EASTERLY OF THE CENTERLINE OF STATE COLLEGE AND 72 FT. SOUTHERLY OF THE CENTERLINE OF AVOCADO AND 134 FT. NORTHERLY OF THE NORTHERLY RAIL ALONG THE SOUTHERN PACIFIC RAILWAY. MONUMENT IS SET LEVEL WITH THE SIDEWALK.

