

Designation: 2F-14-70

Date Destroyed:

Date Revised:

GPS #:

OCS Index Map: Q02-15


Page/Grid: 738/H-5

City / Location: Fullerton

Line #/SSN: 256/0020

Established By: OCS 1970

Monument Type: Orange County Surveyor's 3 3/4"
Aluminum Disk

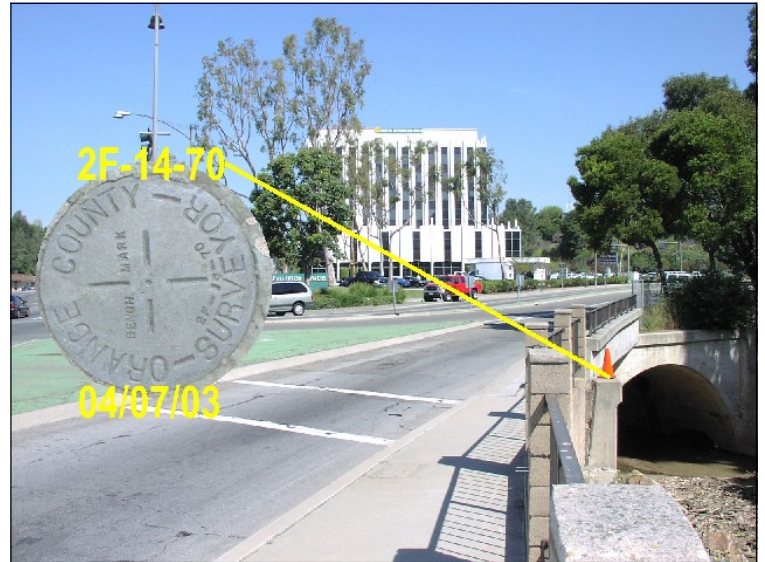

NAVD88 (ft)	NGVD29 (ft)	Year Leveled
199.212	196.792	2005
199.258	196.834	1990

For Reconnaissance Only!	
Latitude (30' +/-)	Longitude (30' +/-)
33 52 58.65	117 55 28.19

Description:

DESCRIBED BY OCS 2003 - FOUND 3 3/4" OCS ALUMINUM BENCHMARK DISK STAMPED "2F-14-70", SET IN THE TOP OF A CONCRETE HEADWALL FOR A CONCRETE BRIDGE CROSSING. MONUMENT IS LOCATED IN THE SOUTHEASTERLY CORNER OF THE INTERSECTION OF HARBOR BOULEVARD AND BREA BOULEVARD, 73 FT. SOUTHERLY OF THE CENTER MEDIAN ALONG BREA AND 5.5 FT. EASTERLY OF THE EASTERLY CURB ALONG HARBOR. MONUMENT IS SET 0.5 FT. ABOVE THE SIDEWALK.

