

## Designation: 2F-19-76

Date Destroyed:

Date Revised:

GPS #:

OCS Index Map: Q02-15


Page/Grid: 738/H-4

City / Location: Fullerton

Line #/SSN: 256/0030

Established By: OCS 1976

Monument Type: Orange County Surveyor's 3 3/4"  
Aluminum Disk

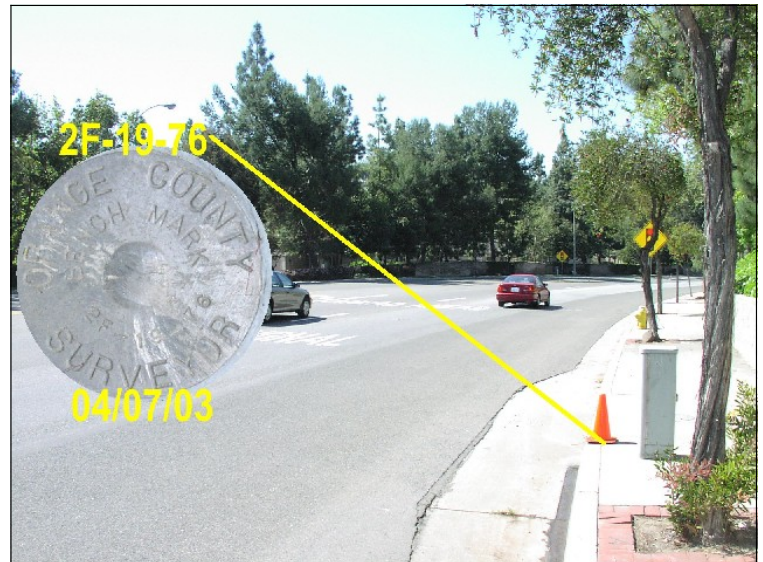

NAVD88 (ft)	NGVD29 (ft)	Year Leveled
230.510	228.090	2005
230.534	228.112	1990

For Reconnaissance Only!	
Latitude (30' +/-)	Longitude (30' +/-)
33 53 18.00	117 55 08.05

### Description:

DESCRIBED BY OCS 2003 - FOUND 3 3/4" OCS ALUMINUM BENCHMARK DISK STAMPED "2F-19-76", SET IN THE NORTHEASTERLY CORNER OF A 5 FT. BY 11 FT. CONCRETE CATCH BASIN. MONUMENT IS LOCATED IN THE SOUTHWESTERLY CORNER OF THE INTERSECTION OF BREA BOULEVARD AND LONGVIEW DRIVE, 95 FT. SOUTHERLY ALONG BREA FROM THE CENTERLINE OF LONGVIEW DRIVE PROLONGED WESTERLY TO THE WEST CURB OF BREA BOULEVARD AND 0.5 FT. WESTERLY OF THE WESTERLY CURB ALONG BREA. MONUMENT IS SET LEVEL WITH THE SIDEWALK.

