Vertical Control Data Sheet
O.C.S. 1995 Adjustment

Designation: 2F-22-86

Date Destroyed:
Date Revised: 5/10/2004
GPS #:
OCS Index Map: Q06-07
Page/Grid: 768/H-5
City / Location: Anaheim

Line #/SSN: 405/0010
Established By: OCS 1986
Monument Type: Orange County Surveyor's 3 3/4" Aluminum Disk

NAVD88 (ft)	NGVD29 (ft)	Year Leveled
153.098	150.680	2005
153.159	150.719	1990

For Reconnaisance Only!	
Latitude (30' +/-)	Longitude (30' +/-)
33 50 11.03	117 55 11.88

Description:
DESCRIBED BY OCS 2004 - FOUND 3 3\4" OCS ALUMINUM BENCHMARK DISK STAMPED "2F-22-86", SET IN THE NORTHWESTERLY CORNER OF A 4 FT. BY 20FT. CONCRETE CATCH BASIN. MONUMENT IS LOCATED IN THE SOUTHEASTERLY CORNER OF THE INTERSECTION OF HARBOR BOULEVARD AND CYPRESS STREET, 20 FT. SOUTHERLY OF THE CENTERLINE OF CYPRESS STREET AND 78 FT. EASTERLY OF THE CENTERLINE OF HARBOR BOULEVARD. MONUMENT IS SET LEVEL WITH THE SIDEWALK

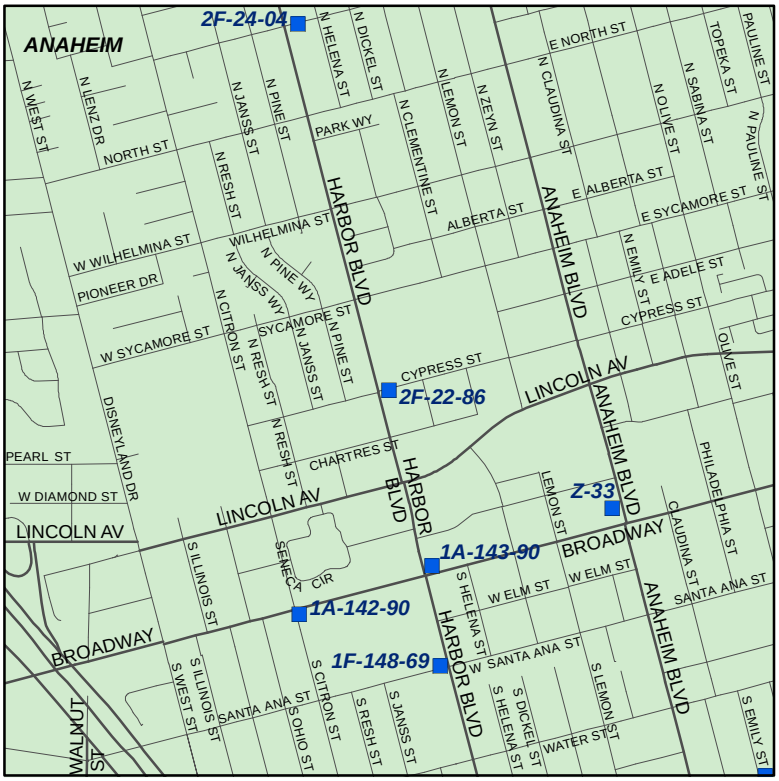

BENCHMARKS MAY HAVE MORE THAN ONE HEIGHT DUE TO THE DATUM, ADJUSTMENTS, AND YEAR LEVELED. TO AVOID CONFUSION, ALWAYS STATE THESE AS REFERENCES WHEN USING BENCHMARK ELEVATION VALUES.