

Designation: 2G-22-70

Date Destroyed: **5/19/2006**

Date Revised:

GPS #:

OCS Index Map: Q03-13


Page/Grid: 739/G-5

City / Location: Placentia

Line #/SSN: 257/0040

Established By: OCS 1970

Monument Type: Orange County Surveyor's 3 3/4"
Aluminum Disk

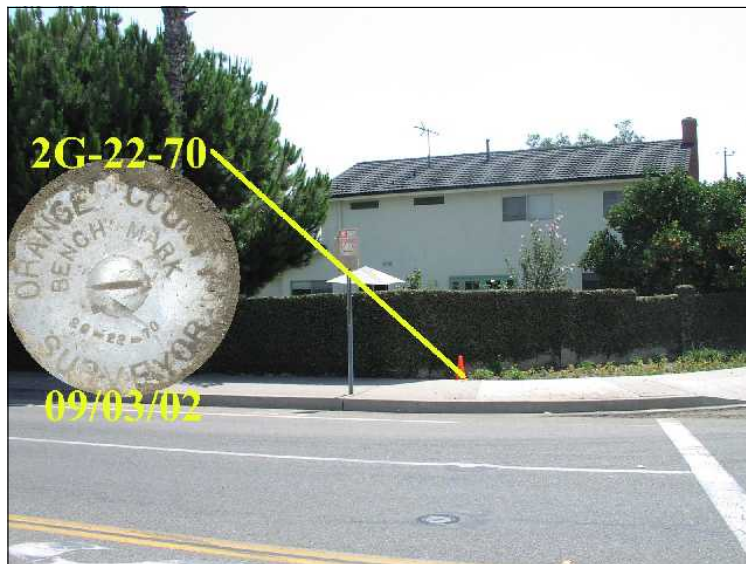

NAVD88 (ft)	NGVD29 (ft)	Year Leveled
300.742	298.333	1990

For Reconnaissance Only!	
Latitude (30' +/-)	Longitude (30' +/-)
33 53 08.37	117 51 16.76

Description:

REPORTED DESTROYED (SEE DATE IN DESTROYED BOX) - ORIGINAL DESCRIPTION BEING: DESCRIBED BY OCS 2003 - FOUND 3 3/4" OCS ALUMINUM BENCHMARK DISK STAMPED "2G-22-70", SET IN THE TOP OF A 6 IN. CONCRETE POST. MONUMENT IS LOCATED IN THE SOUTHEASTERLY CORNER OF THE INTERSECTION OF PALM DRIVE AND VALENCIA AVENUE, 41 FT. SOUTHERLY OF THE CENTERLINE OF PALM AND 42 FT. EASTERLY OF THE CENTERLINE OF VALENCIA. MONUMENT IS SET LEVEL WITH THE GROUND.

NO
LOCATION
MAP