Designation: 2J-49-76

Date Destroyed:

Date Revised:

GPS #:

OCS Index Map: Q07-06

Page/Grid: 770/A-4

City / Location: Anaheim

Line #/SSN: 259/0030

Established By: OCS 1976

Monument Type: Orange County Surveyor's 3 3/4" Aluminum Disk

NAVD88 (ft)	NGVD29 (ft)	Year Leveled
330.771	328.363	1992

For Reconnaisance Only!	
Latitude (30' +/-)	Longitude (30' +/-)
33 50 30.90	117 49 47.26

Description:
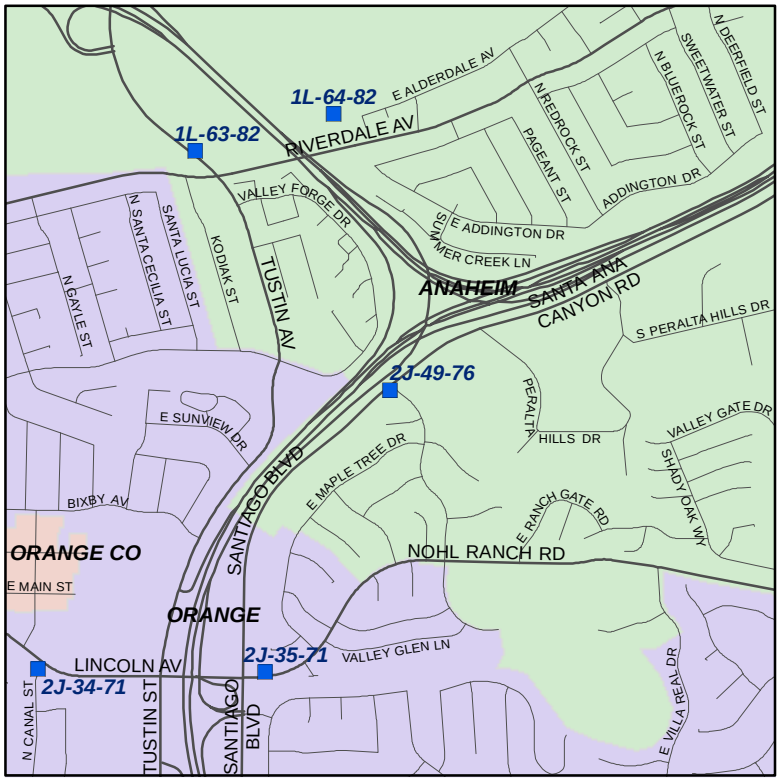
DESCRIBED BY OCS 2002 - FOUND 3 3\4" OCS ALUMINUM BENCHMARK DISK STAMPED "2J-49-76", SET IN THE NORTHEASTERLY CORNER OF A 4 FT. BY 4 FT. CONCRETE CATCH BASIN. MONUMENT IS LOCATED IN THE SOUTHWESTERLY CORNER OF THE INTERSECTION OF NOHL CANYON ROAD AND SANTIAGO BOULEVARD, 34 FT. SOUTHERLY OF THE CENTERLINE OF SANTIAGO BOULEVARD AND 51 FT. WESTERLY OF THE CENTERLINE OF NOHL CANYON ROAD. MONUMENT IS SET LEVEL WITH THE TOP OF THE CURB.