

Designation: 2J-66-89

Date Destroyed:

Date Revised:

GPS #:

OCS Index Map: Q08-01


Page/Grid: 741/D-6

City / Location: Yorba Linda

Line #/SSN: 403/0850

Established By: OCS 1989

Monument Type: Orange County Surveyor's 3 3/4"
Aluminum Disk

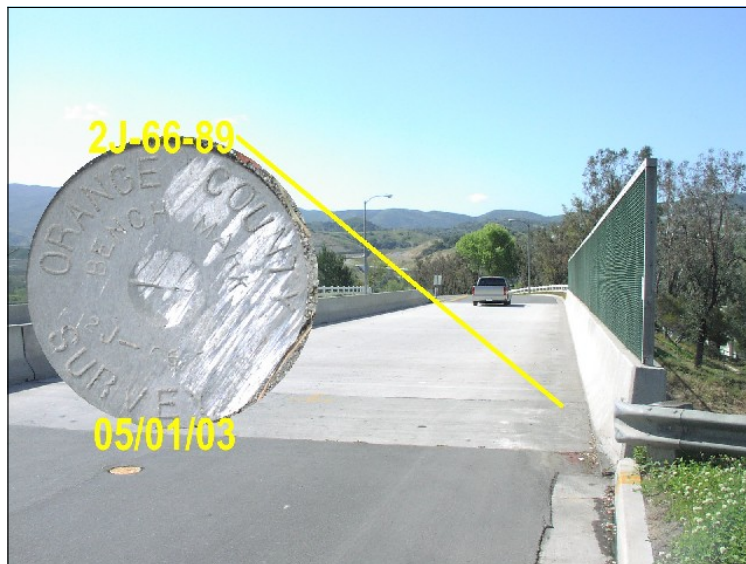

NAVD88 (ft)	NGVD29 (ft)	Year Leveled
438.168	435.756	1989

For Reconnaissance Only!	
Latitude (30' +/-)	Longitude (30' +/-)
33 52 26.27	117 43 21.97

Description:

DESCRIBED BY OCS 2003 - FOUND 3 3/4" OCS ALUMINUM BENCHMARK DISK STAMPED "2J-66-89", SET IN THE WESTERLY END OF A CONCRETE BRIDGE. MONUMENT IS LOCATED IN THE NORTHWESTERLY CORNER OF THE INTERSECTION OF VIA LOMAS DE YORBA EAST AND THE ATCHINSON/TOPEKA/SANTA FE RAILWAY CROSSING, 27 FT. WESTERLY OF THE CENTERLINE OF VIA LOMAS DE YORBA AND 76.5 FT. NORTHERLY OF THE CENTERLINE OF THE RAILWAY. MONUMENT IS SET LEVEL WITH THE BRIDGE DECK.

