

Designation: 3B-104-91

Date Destroyed:

Date Revised:

GPS #:

OCS Index Map: Q12-07


Page/Grid: 860/E-2

City / Location: Irvine

Line #/SSN: 402/0470

Established By: OCS 1991

Monument Type: Orange County Surveyor's 3 3/4"
Aluminum Disk

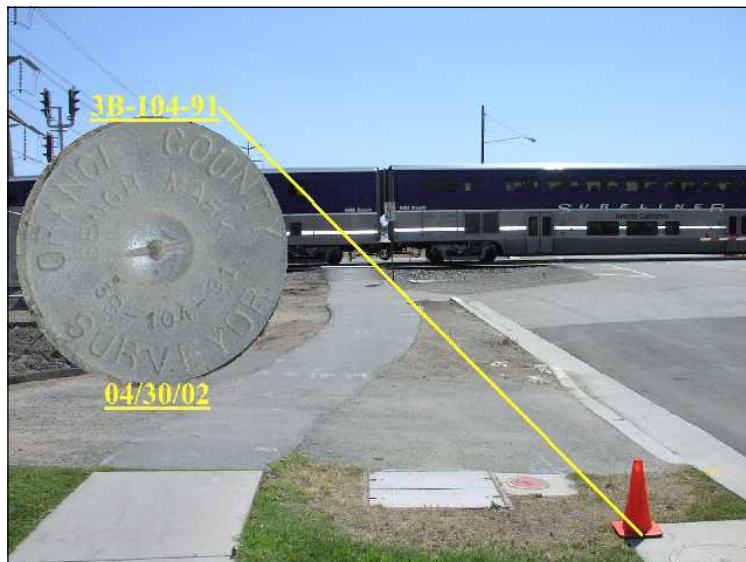

NAVD88 (ft)	NGVD29 (ft)	Year Leveled
61.905	59.504	2003
61.934	59.527	1991

For Reconnaissance Only!	
Latitude (30' +/-)	Longitude (30' +/-)
33 42 14.28	117 47 58.20

Description:

DESCRIBED BY OCS 2002 - FOUND 3 3/4" OCS ALUMINUM BENCHMARK DISK STAMPED "3B-104-91", SET IN THE SOUTHERLY CORNER OF A 4 FT. BY 4 FT. CONCRETE CATCH BASIN. MONUMENT IS LOCATED IN THE EASTERLY CORNER OF THE INTERSECTION OF HARVARD AVENUE AND THE ATCHINSON TOPEKA AND SANTA FE RAILROAD, 40 FT. SOUTHEASTERLY OF THE CENTERLINE OF HARVARD AND 107 FT. NORTHEASTERLY OF THE NORTHEAST RAIL ALONG THE RAILWAY. MONUMENT IS SET LEVEL WITH THE SIDEWALK.

