

Designation: 3B-106-91

Date Destroyed:

Date Revised:

GPS #:

OCS Index Map: Q12-06


Page/Grid: 860/D-1

City / Location: Tustin

Line #/SSN: 402/0500

Established By: OCS 1991

Monument Type: Orange County Surveyor's 3 3/4"
Aluminum Disk

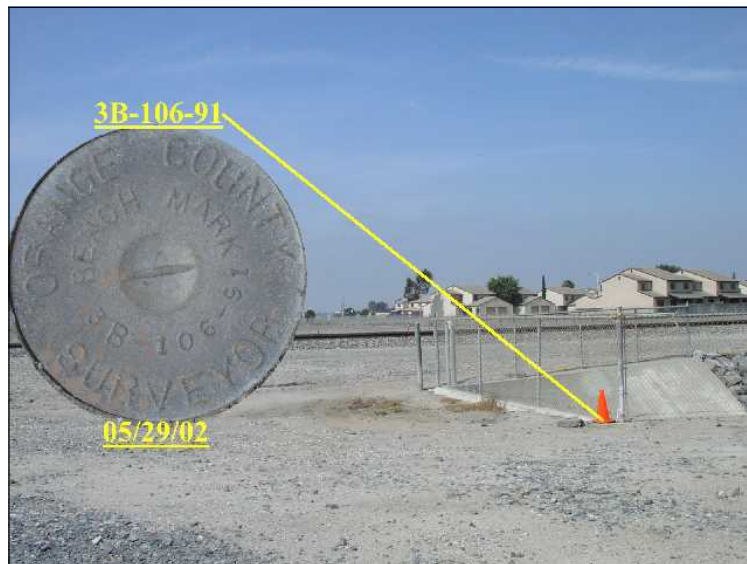

NAVD88 (ft)	NGVD29 (ft)	Year Leveled
68.113	65.707	2003
68.207	65.789	1991

For Reconnaissance Only!	
Latitude (30' +/-)	Longitude (30' +/-)
33 42 57.81	117 49 01.10

Description:

DESCRIBED BY OCS 2002 - FOUND 3 3/4" OCS ALUMINUM BENCHMARK DISK STAMPED "3B-106-91", SET IN THE NORTHERLY ANGLE POINT OF AN 80 FT. REINFORCED CONCRETE BOX. MONUMENT IS LOCATED ALONG THE NORTHERLY SIDE OF THE ATCHINSON TOPEKA AND SANTA FE RAILROAD, 0.7 MILES ALONG THE RAILWAY FROM THE CENTERLINE CROSSING OF REDHILL AVENUE AND 90 FT. NORTHERLY OF THE NORTHERLY RAIL. MONUMENT IS SET LEVEL WITH THE TOP OF THE BOX.

