

Designation: 3C-22-71

Date Destroyed:

Date Revised: 7/7/2015

GPS #: 1554

OCS Index Map: Q07-14


Page/Grid: 830/C-1

City / Location: East Tustin

Line #/SSN: 353/0020

Established By: OCS 1971

Monument Type: Orange County Surveyor's 3 3/4"
Aluminum Disk

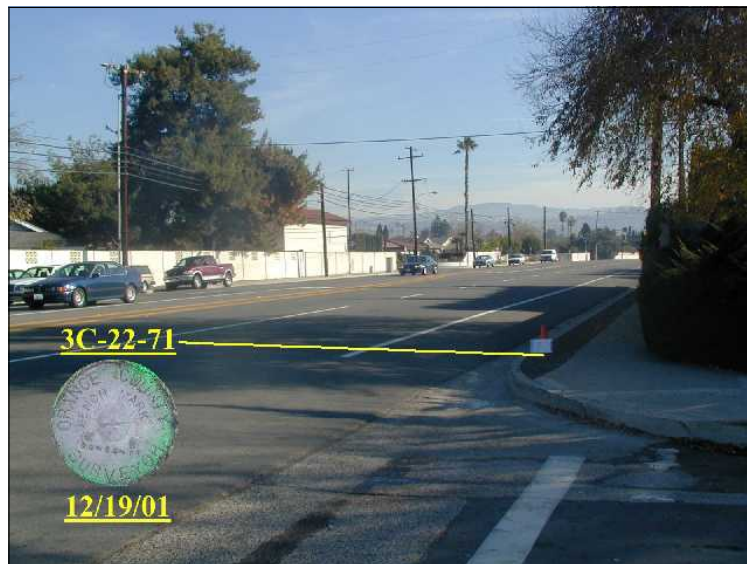

NAVD88 (ft)	NGVD29 (ft)	Year Leveled
174.752	172.319	2015
174.752	172.319	2010
174.733	172.296	1991

For Reconnaissance Only!	
Latitude (30' +/-)	Longitude (30' +/-)
33 45 35.42970	117 49 00.42470

Description:

NOTE: MONUMENT IS SET IN KNOWN SUBSIDENCE ZONE AND MAY NOT FIT ADJACENT BENCHMARKS. DESCRIBED BY OCS 2001 - FOUND 3 3/4" OCS ALUMINUM BENCHMARK DISK STAMPED "3C-22-71", SET IN THE TOP OF A 4 IN. BY 4 IN. CONCRETE POST. MONUMENT IS LOCATED IN THE SOUTHEAST CORNER OF THE INTERSECTION OF LAMBETH WAY AND 17TH STREET, 43 FT. SOUTHERLY OF THE CENTERLINE OF 17TH STREET AND 42.6 FT. EASTERLY OF THE CENTERLINE OF LAMBETH WAY. MONUMENT IS SET UP 0.1 FT. FROM THE TOP OF CURB.

