

## Designation: 3E-119-99

Date Destroyed:

Date Revised: 5/19/1999

GPS #:

OCS Index Map: Q13-10


Page/Grid: 861/F-5

City / Location: Unin., Orange Co.

Line #/SSN: 355/0350

Established By: OCS 1999

Monument Type: Orange County Surveyor's 3 3/4"  
Aluminum Disk

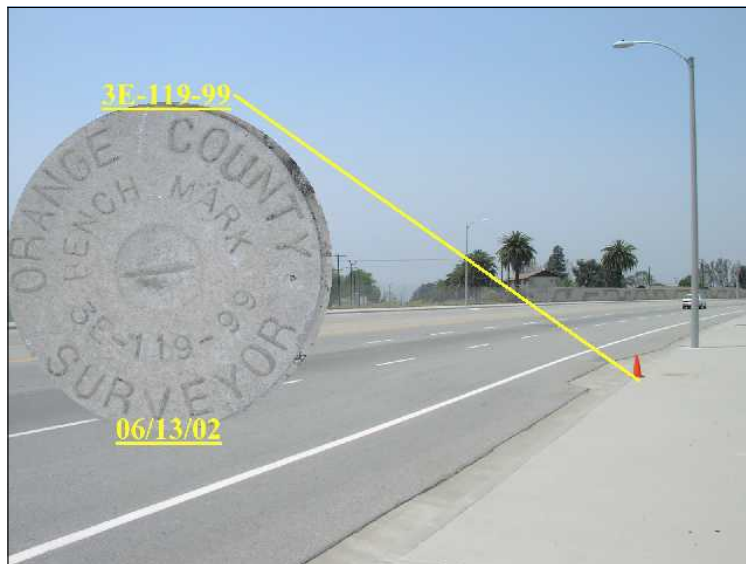

NAVD88 (ft)	NGVD29 (ft)	Year Leveled
428.307	425.927	1999

For Reconnaissance Only!	
Latitude (30' +/-)	Longitude (30' +/-)
33 40 38.56	117 42 52.81

### Description:

DESCRIBED BY OCS 2002 - FOUND 3 3/4" OCS ALUMINUM BENCHMARK DISK STAMPED "3E-119-99", SET IN THE SOUTHWESTERLY CORNER OF A 4 FT. BY 11 FT. CONCRETE CATCH BASIN. MONUMENT IS LOCATED ALONG THE NORTHEASTERLY SIDE OF IRVINE BOULEVARD, 800 FT. NORTHWESTERLY OF THE CENTERLINE OF DESERT STORM ROAD AND 60 FT. NORTHEASTERLY OF THE CENTERLINE OF IRVINE BOULEVARD. MONUMENT IS SET LEVEL WITH THE SIDEWALK.

