

## Designation: 3E-124-04

Date Destroyed: **5/10/2010**

Date Revised: 8/24/2004

GPS #:

OCS Index Map: Q13-05


Page/Grid: 831/D-3

City / Location: Unin., Orange Co.

Line #/SSN: 355/0420

Established By: OCS 2004

Monument Type: Orange County Surveyor's 3 3/4"  
Aluminum Disk

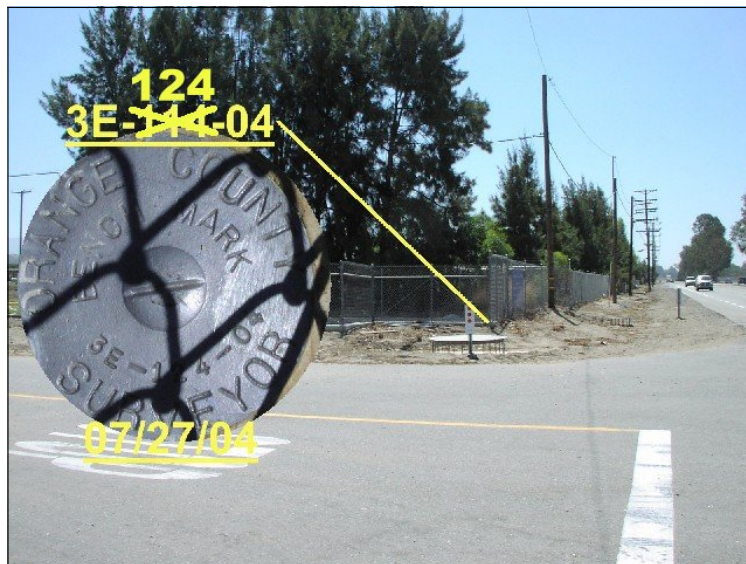

NAVD88 (ft)	NGVD29 (ft)	Year Leveled
395.474	393.088	2004

For Reconnaissance Only!	
Latitude (30' +/-)	Longitude (30' +/-)
33 41 20.46	117 43 26.93

### Description:

REPORTED DESTROYED (SEE DATE IN DESTROYED BOX) - ORIGINAL DESCRIPTION BEING: DESCRIBED BY OCS 2004 - FOUND 3 3/4" OCS ALUMINUM BENCHMARK DISK STAMPED "3E-124-04", SET IN THE TOP SOUTHWESTERLY CORNER OF A CONCRETE HEADWALL FOR A BOX CULVERT. MONUMENT IS LOCATED IN THE NORTHEASTERLY CORNER OF THE INTERSECTION OF IRVINE BOULEVARD AND LAMBERT ROAD, 60.5 FT. NORTHEASTERLY OF THE CENTERLINE OF IRVINE BOULEVARD AND 44 FT. SOUTHERLY OF THE CENTERLINE OF LAMBERT ROAD. MONUMENT IS SET LEVEL WITH THE SIDEWALK

NO  
LOCATION  
MAP