

## Designation: 3E-73-71R86

Date Destroyed: **3/1/2011**

Date Revised:

GPS #:

OCS Index Map: Q13-05


Page/Grid: 861/B-2

City / Location: Unin., Orange Co.

Line #/SSN: 355/0210

Established By: OCS 1971

Monument Type: Orange County Surveyor's 3 3/4"  
Aluminum Disk

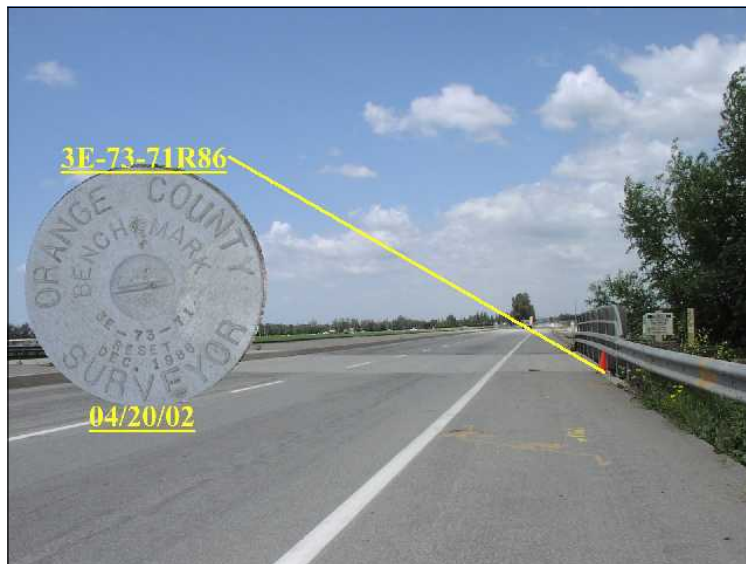

| NAVD88 (ft) | NGVD29 (ft) | Year Leveled |
|-------------|-------------|--------------|
| 269.844     | 267.451     | 1991         |
|             |             |              |
|             |             |              |
|             |             |              |
|             |             |              |

| For Reconnaissance Only! |                     |
|--------------------------|---------------------|
| Latitude (30' +/-)       | Longitude (30' +/-) |
| 33 42 10.10              | 117 44 37.74        |

### Description:

REPORTED DESTROYED (SEE DATE IN DESTROYED BOX) - ORIGINAL DESCRIPTION BEING: DESCRIBED BY OCS 2002 - FOUND 3 3/4" OCS ALUMINUM BENCHMARK DISK STAMPED "3E-73-71R86", SET IN THE TOP OF A CONCRETE BRIDGE ABUTMENT. MONUMENT IS LOCATED ALONG THE NORTHEASTERLY SIDE OF IRVINE BOULEVARD, 0.5 MILES NORTHWESTERLY OF SAND CANYON, 42.5 FT. NORTHEASTERLY OF THE CENTERLINE OF IRVINE AND 9.5 FT. NORTHWESTERLY OF THE NORTHEASTERLY END OF THE NORTHEASTERLY ABUTMENT. MONUMENT IS SET LEVEL WITH THE BRIDGE DECK.

NO  
LOCATION  
MAP