

Designation: 3EE-25-92

Date Destroyed:

Date Revised:

GPS #: 1451

OCS Index Map: Q17-08


Page/Grid: 922/E-3

City / Location: Mission Viejo

Line #/SSN: 378/0100

Established By: OCS 1991

Monument Type: Orange County Surveyor's 3 3/4"
Aluminum Disk

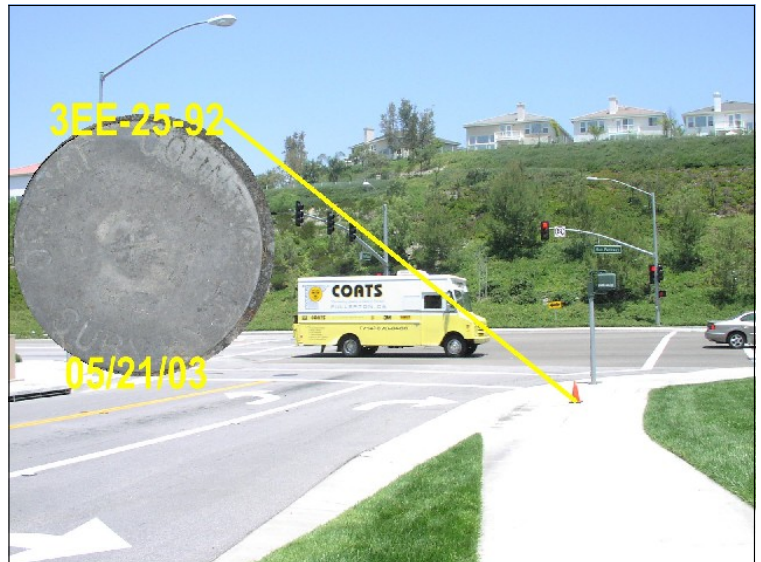

NAVD88 (ft)	NGVD29 (ft)	Year Leveled
621.357	619.011	1995

For Reconnaissance Only!	
Latitude (30' +/-)	Longitude (30' +/-)
33 35 18.10974	117 38 35.73220

Description:

DESCRIBED BY OCS 2003 - FOUND 3 3/4" OCS ALUMINUM BENCHMARK DISK STAMPED "3EE-25-92", SET IN THE NORTHEASTERLY CORNER OF A 4 FT. BY 16 FT. CONCRETE CATCH BASIN. MONUMENT IS LOCATED IN THE SOUTHEASTERLY CORNER OF THE INTERSECTION OF SAN RAFAEL AND OSO PARKWAY, 90 FT. SOUTHERLY OF THE CENTERLINE OF OSO AND 25 FT. EASTERLY OF THE CENTERLINE OF SAN RAFAEL. MONUMENT IS SET LEVEL WITH THE SIDEWALK.

