

Designation: 3F-106-77R86

Date Destroyed: **6/19/2007**

Date Revised: 4/7/2004

GPS #:

OCS Index Map: Q12-09


Page/Grid: 859/H-4

City / Location: Irvine

Line #/SSN: 356/0380

Established By: OCS 1986

Monument Type: Orange County Surveyor's 3 3/4"
Aluminum Disk

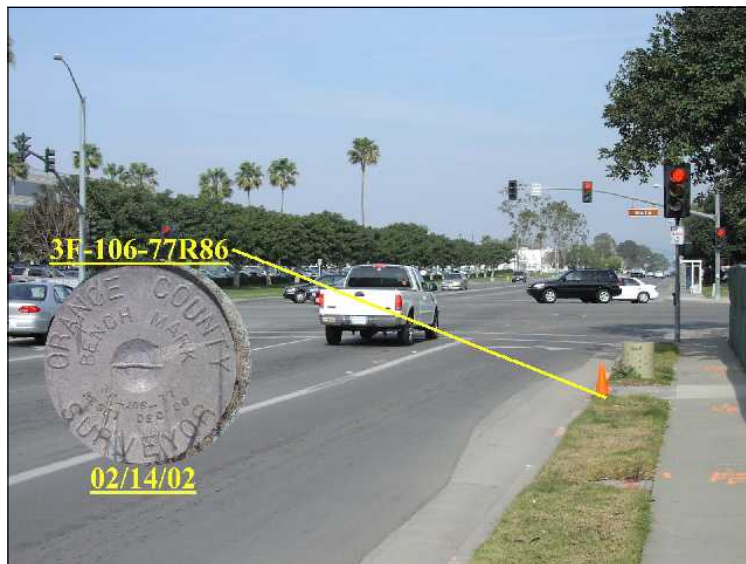

NAVD88 (ft)	NGVD29 (ft)	Year Leveled
35.154	32.753	2003
35.378	32.975	1989

For Reconnaissance Only!	
Latitude (30' +/-)	Longitude (30' +/-)
33 41 02.0	117 50 52.0

Description:

REPORTED DESTROYED (SEE DATE IN DESTROYED BOX) - ORIGINAL DESCRIPTION BEING: DESCRIBED BY OCS 2002 - FOUND 3 3/4" OCS ALUMINUM BENCHMARK DISK STAMPED "3F-106-77R86", SET IN THE WESTERLY CORNER OF A 4 FT. BY 8 FT. CONCRETE CATCH BASIN. MONUMENT IS LOCATED IN THE SOUTHERLY CORNER OF THE INTERSECTION OF VON KARMAN AND MAIN STREET, 58 FT. SOUTHEASTERLY OF THE CENTERLINE OF VON KARMAN AND 54 FT. SOUTHWESTERLY OF THE SOUTHWEST END OF THE SOUTH CURB RETURN. MONUMENT IS SET LEVEL WITH THE SIDEWALK.

NO
LOCATION
MAP