

## Designation: 3G-31-91

Date Destroyed:

Date Revised:

GPS #:

OCS Index Map: Q07-12


Page/Grid: 800/J-4

City / Location: Orange

Line #/SSN: 357/0020

Established By: OCS 1978

Monument Type: Orange County Surveyor's 3 3/4"  
Aluminum Disk

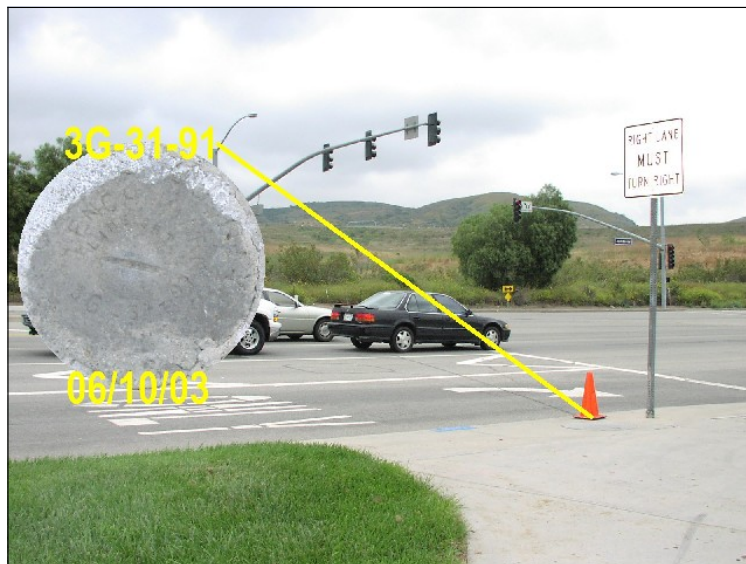

NAVD88 (ft)	NGVD29 (ft)	Year Leveled
558.661	556.246	1991

For Reconnaissance Only!	
Latitude (30' +/-)	Longitude (30' +/-)
33 47 07.00	117 45 31.56

### Description:

DESCRIBED BY OCS 2003 - FOUND 3 3/4" OCS ALUMINUM BENCHMARK DISK STAMPED "3G-31-91", SET IN THE SOUTHEASTERLY CORNER OF A 4 FT. BY 12 FT. CONCRETE CATCH BASIN. MONUMENT IS LOCATED IN THE NORTHWESTERLY CORNER OF THE INTERSECTION OF CANYON VIEW AVENUE AND JAMBOREE ROAD, 74 FT. WESTERLY OF THE CENTERLINE OF JAMBOREE AND 80 FT. NORTHERLY OF THE CENTERLINE OF CANYON VIEW. MONUMENT IS SET LEVEL WITH THE SIDEWALK.

