

Designation: 3G-40-91

Date Destroyed:

Date Revised:

GPS #:

OCS Index Map: Q12-03


Page/Grid: 830/F-5

City / Location: Tustin

Line #/SSN: 357/0100

Established By: OCS 1991

Monument Type: Orange County Surveyor's 3 3/4"
Aluminum Disk

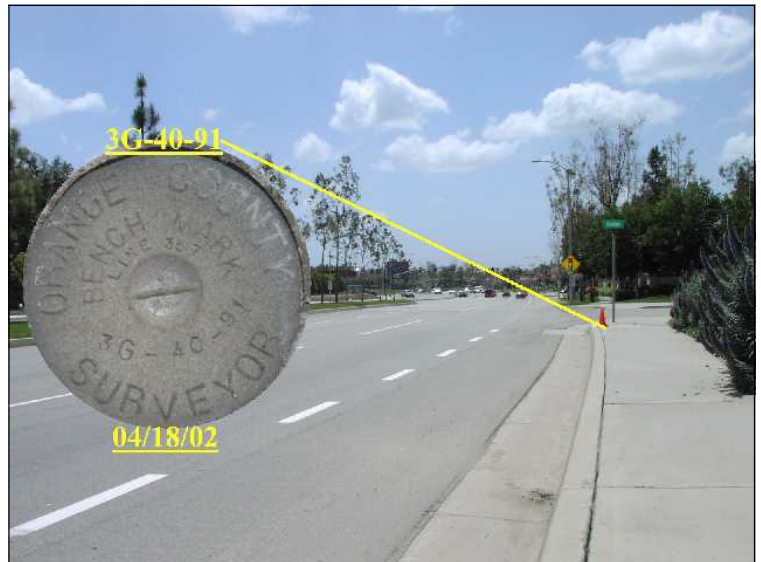

NAVD88 (ft)	NGVD29 (ft)	Year Leveled
127.695	125.283	1991

For Reconnaissance Only!	
Latitude (30' +/-)	Longitude (30' +/-)
33 43 55.35	117 47 08.91

Description:

DESCRIBED BY OCS 2002 - FOUND 3 3/4" OCS ALUMINUM BENCHMARK DISK STAMPED "3G-40-91", SET IN THE NORTHEASTERLY CORNER OF A 4 FT. BY 4 FT. CONCRETE CATCH BASIN. MONUMENT IS LOCATED IN THE NORTHWESTERLY CORNER OF THE INTERSECTION OF JAMBOREE ROAD AND KELLER DRIVE, 56 FT. NORTHERLY OF THE CENTERLINE OF KELLER AND 56 FT. WESTERLY OF THE CENTERLINE OF JAMBOREE. MONUMENT IS SET LEVEL WITH THE SIDEWALK.

