Vertical Control Data Sheet
O.C.S. 1995 Adjustment

Designation: 3HH-12-77

Date Destroyed:
Date Revised: 9/14/1999
GPS #:
OCS Index Map: Q13-16
Page/Grid: 892/E-2
City / Location: Mission Viejo

Line #/SSN: 348/0120
Established By: OCS 1977
Monument Type: Orange County Surveyor's 3 3/4" Aluminum Disk

NAVD88 (ft)	NGVD29 (ft)	Year Leveled
792.108	789.757	2004
792.005	789.655	1999
792.108	789.757	1989

For Reconnaisance Only!	
Latitude (30' +/-)	Longitude (30' +/-)
33 38 02.46	117 38 50.24
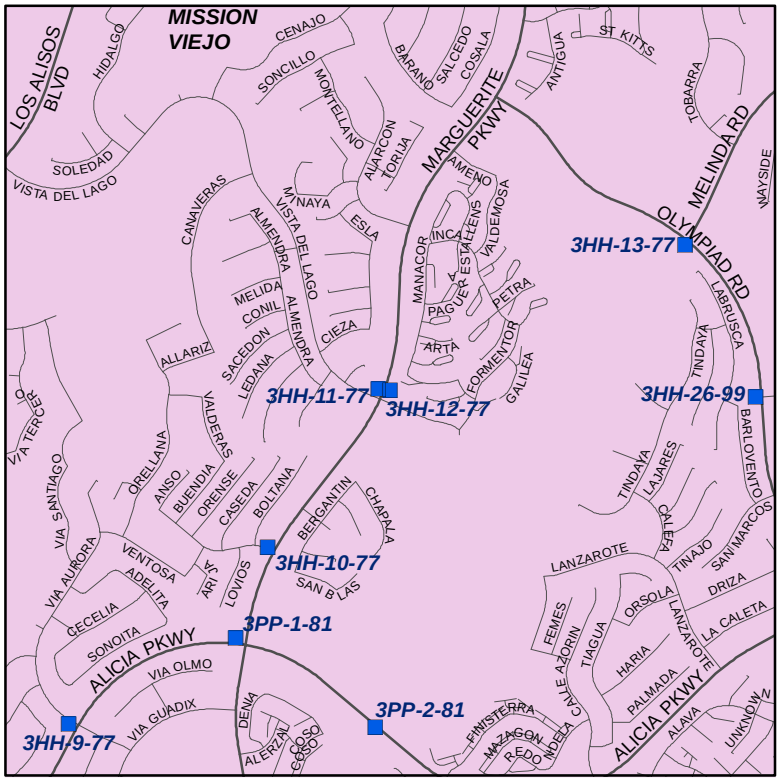
Description:
DESCRIBED BY OCS 2002 - FOUND 3 3\4" OCS ALUMINUM BENCHMARK DISK STAMPED "3HH-12-77", SET IN THE NORTHWESTERLY CORNER OF A 5 FT. BY 29 FT. CONCRETE CATCH BASIN. MONUMENT IS LOCATED ALONG THE EASTERLY SIDE OF MARGUERITE PARKWAY, 435 FT. SOUTHERLY OF THE CENTERLINE OF OLYMPIAD ROAD, AND 1 FT. EASTERLY OF THE EASTERLY CURB ALONG MARGUERITE. MONUMENT IS SET LEVEL WITH THE SIDEWALK.