

## VERTICAL CONTROL DATA SHEET O.C.S. 1995 ADJUSTMENT



## Designation: 3HH-21-91

**Date Destroyed:** 

**Date Revised:** 

GPS #:

OCS Index Map: Q17-04 Page/Grid: 892/F-6


City / Location: Mission Viejo

Line #/SSN: 348/0160 Established By: OCS 1991

Monument Type: Orange County Surveyor's 3 3/4"

**Aluminum Disk** 

NAVD88 (ft)	NGVD29 (ft)	Year Leveled
753.757	751.407	1991

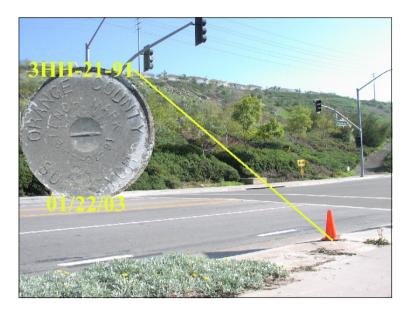

For Reconnaisance Only!		
Latitude (30' +/-)	Longitude (30' +/-)	
33 36 58.68	117 37 52.12	

## **Description:**

DESCRIBED BY OCS 2003 - FOUND 3 3\4" OCS ALUMINUM BENCHMARK DISK STAMPED "3HH-21-91", SET IN THE SOUTHEASTERLY CORNER OF A 4 FT. BY 6 FT. CONCRETE CATCH BASIN. MONUMENT IS LOCATED IN THE NORTHWESTERLY CORNER OF THE INTERSECTION OF JERONIMO ROAD AND OLYMPIAD ROAD, 20 FT. NORTHERLY OF THE CENTERLINE OF OLYMPIAD AND 85 FT. WESTERLY OF THE CENTERLINE OF JERONIMO. MONUMENT IS SET LEVEL WITH THE SIDEWALK.

