Vertical Control Data Sheet
O.C.S. 1995 Adjustment

Designation: 3LL-5-78

Date Destroyed:

Date Revised:

GPS #:

OCS Index Map: Q20-03

Page/Grid: 972/B-2

City / Location: San Juan Capistrano

Line #/SSN: 345/0050

Established By: OCS 1978

Monument Type: Orange County Surveyor's 3 3/4" Aluminum Disk

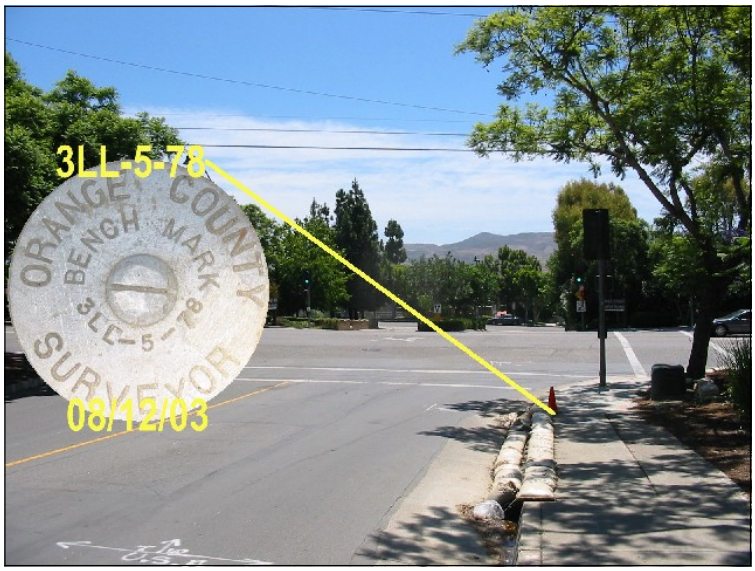

NAVD88 (ft)	NGVD29 (ft)	Year Leveled
121.859	119.553	1990

For Reconnaisance Only!	
Latitude (30' +/-)	Longitude (30' +/-)
33 29 48.76	117 40 29.97

Description:
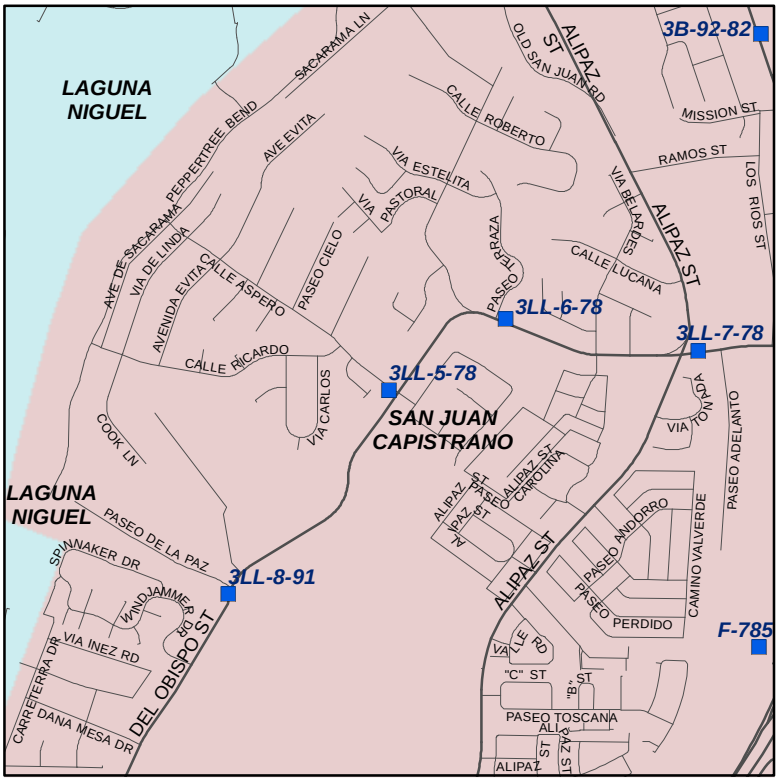
DESCRIBED BY OCS 2003 - FOUND 3 3\4" OCS ALUMINUM BENCHMARK DISK STAMPED "3LL-5-78", SET IN THE NORTHEASTERLY CORNER OF A 4 FT. BY 22 FT. CONCRETE CATCH BASIN. MONUMENT IS LOCATED IN THE SOUTHWESTERLY CORNER OF THE INTERSECTION OF DEL OBISPO STREET AND CALLE ASPERO, 69 FT. WESTERLY OF THE CENTERLINE OF DEL OBISPO AND 21 FT. SOUTHERLY OF THE CENTERLINE OF CALLE ASPERO. MONUMENT IS SET LEVEL WITH THE SIDEWALK.