

Designation: 3LL-7-78

Date Destroyed:

Date Revised:

GPS #: 0761

OCS Index Map: Q20-03


Page/Grid: 972/C-2

City / Location: San Juan Capistrano

Line #/SSN: 345/0070

Established By: OCS 1978

Monument Type: Orange County Surveyor's 3 3/4"
Aluminum Disk

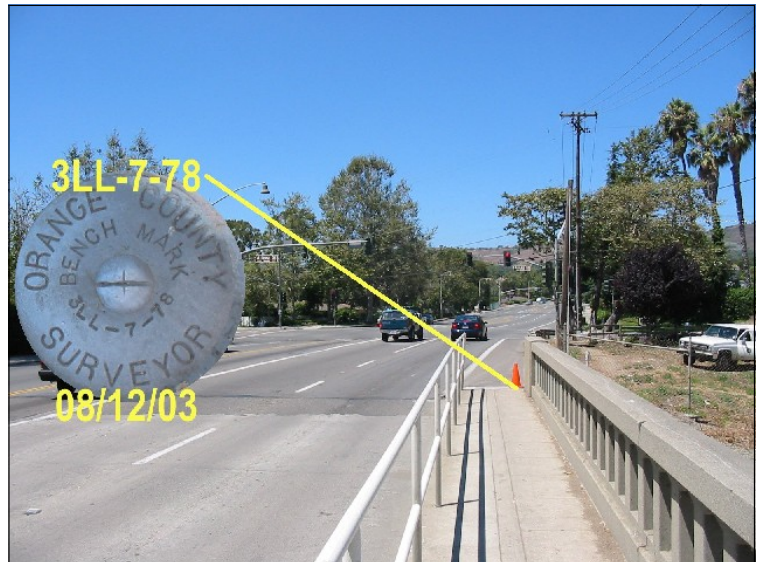

NAVD88 (ft)	NGVD29 (ft)	Year Leveled
98.227	95.919	1990

For Reconnaissance Only!	
Latitude (30' +/-)	Longitude (30' +/-)
33 29 52.57112	117 39 58.22266

Description:

DESCRIBED BY OCS 2003 - FOUND 3 3/4" OCS ALUMINUM BENCHMARK DISK STAMPED "3LL-7-78", SET IN THE NORTHWESTERLY CORNER OF A CONCRETE BRIDGE. MONUMENT IS LOCATED IN THE NORTHEASTERLY CORNER OF THE INTERSECTION OF ALIPAZ STREET AND DEL OBISPO STREET, 150 FT. EASTERLY OF THE CENTERLINE OF ALIPAZ AND 31 FT. NORTHERLY OF THE CENTERLINE OF DEL OBISPO. MONUMENT IS SET LEVEL WITH THE SIDEWALK.

