

Designation: 3M-29-99

Date Destroyed:

Date Revised: 4/7/2004

GPS #:

OCS Index Map: Q12-13


Page/Grid: 889/H-5

City / Location: Irvine

Line #/SSN: 362/0150

Established By: OCS 1999

Monument Type: Orange County Surveyor's 3 3/4"
Aluminum Disk

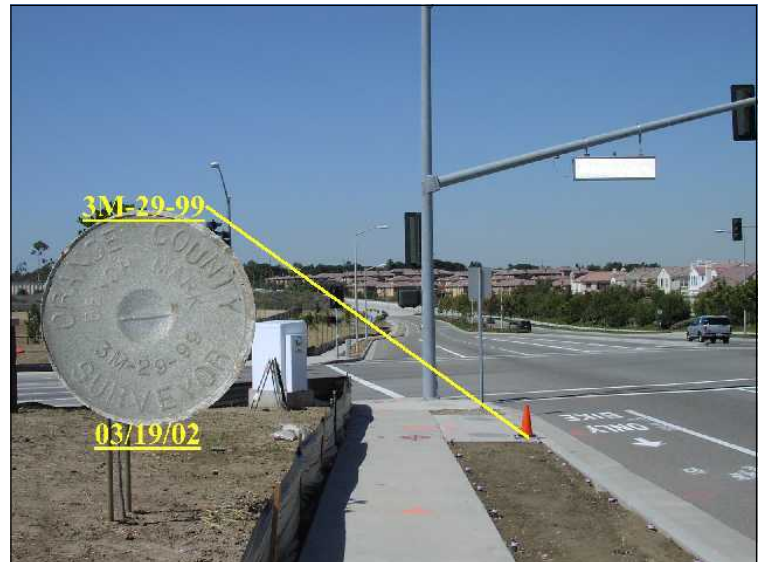

NAVD88 (ft)	NGVD29 (ft)	Year Leveled
192.498	190.127	2004
192.553	190.174	1999

For Reconnaissance Only!	
Latitude (30' +/-)	Longitude (30' +/-)
33 37 41.63	117 51 17.03

Description:

DESCRIBED BY OCS 2002 - FOUND 3 3/4" OCS ALUMINUM BENCHMARK DISK STAMPED "3M-29-99" SET IN THE TOP NORTHEAST CORNER OF A 5.0 FT. BY 15.0 FT. CONCRETE CATCH BASIN. MONUMENT IS LOCATED IN THE SOUTHEASTERLY CORNER OF THE INTERSECTION OF BONITA CANYON ROAD AND MESA VIEW, 50 FT. SOUTHERLY OF THE CENTERLINE OF BONITA CANYON ROAD AND 80 FT. EASTERLY OF THE CENTERLINE OF MESA VIEW. MONUMENT IS SET LEVEL WITH THE SIDEWALK.

