Vertical Control Data Sheet
O.C.S. 1995 Adjustment

Designation: 3MM-22-87

Date Destroyed:
Date Revised:
GPS #:
OCS Index Map: Q17-15
Page/Grid: 952/A-6
City / Location: Laguna Niguel

Line #/SSN: 396/0090
Established By: OCS 1987
Monument Type: Orange County Surveyor's 3 3/4" Aluminum Disk

NAVD88 (ft)	NGVD29 (ft)	Year Leveled
546.367	544.049	1991

For Reconnaisance Only!	
Latitude (30' +/-)	Longitude (30' +/-)
33 30 47.62	117 40 54.71
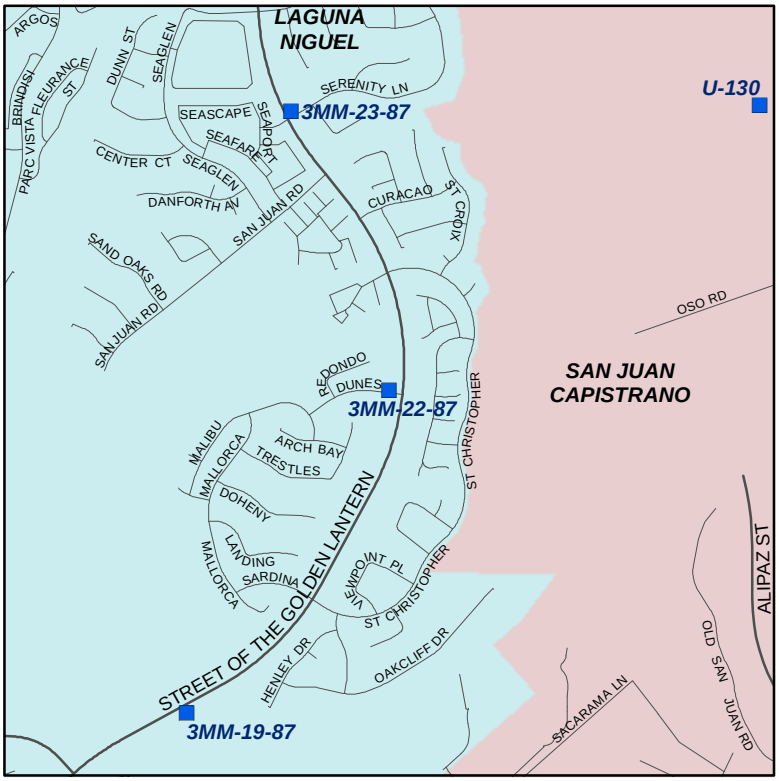
Description:
DESCRIBED BY OCS 2003 - FOUND 3 3\4" OCS ALUMINUM BENCHMARK DISK STAMPED "3MM-22-87", SET IN THE NORTHEASTERLY CORNER OF A 5 FT. BY 22 FT. CONCRETE CATCH BASIN. MONUMENT IS LOCATED IN THE NORTHWESTERLY CORNER OF THE INTERSECTION OF THE STREET OF THE GOLDEN LANTERN AND DUNES STREET, 25 FT. NORTHERLY OF THE CENTERLINE OF DUNES AND 96 FT. WESTERLY OF THE WESTERLY LANES OF GOLDEN LANTERN. MONUMENT IS SET LEVEL WITH THE SIDEWALK.