

Designation: 3NN-2-80

Date Destroyed:

Date Revised:

GPS #:

OCS Index Map: Q18-14


Page/Grid: 953/F-6

City / Location: Unin., Orange Co.

Line #/SSN: 379/0020

Established By: OCS 1980

Monument Type: Orange County Surveyor's 3 3/4"
Aluminum Disk

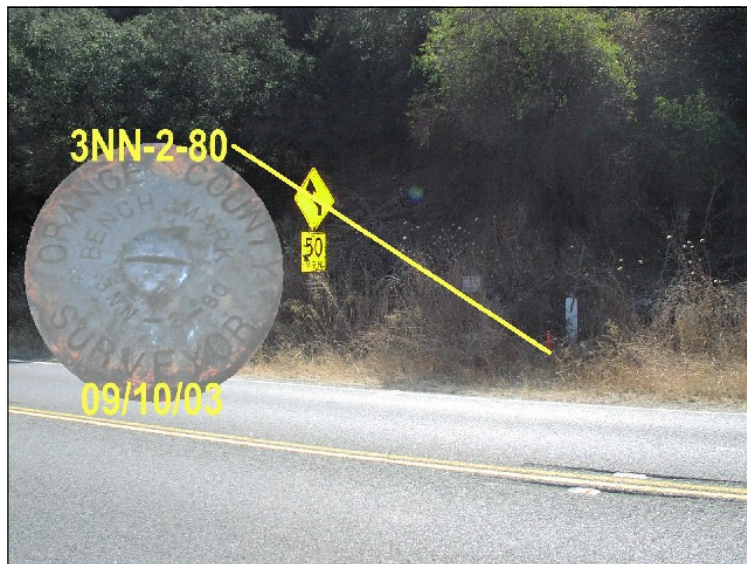

NAVD88 (ft)	NGVD29 (ft)	Year Leveled
326.512	324.181	1992

For Reconnaissance Only!	
Latitude (30' +/-)	Longitude (30' +/-)
33 31 04.62	117 33 44.41

Description:

DESCRIBED BY OCS 2003 - FOUND 3 3/4" OCS ALUMINUM BENCHMARK DISK STAMPED "3NN-2-80", SET IN THE TOP OF A 6 IN. BY 6 IN. CONCRETE POST. MONUMENT IS LOCATED ALONG THE SOUTHWESTERLY SIDE OF ORTEGA HIGHWAY, 6.25 MILES EASTERLY OF THE INTERSTATE 5 FREEWAY, 15 FT. SOUTHWESTERLY OF A YELLOW 50 MPH SPEED LIMIT SIGN, 16 FT. SOUTHEASTERLY OF THE EDGE OF ORTEGA AND 1.5 FT. EASTERLY OF AN OCS PADDLEBOARD. MONUMENT IS SET DOWN 0.1 FT. BELOW GROUND.

