

## Designation: 3NN-6-80

Date Destroyed: **11/24/2006**

Date Revised:

GPS #: 1501

OCS Index Map: Q18-11


Page/Grid: 953/G-1

City / Location: Caspers Reg. Park

Line #/SSN: 379/0060

Established By: OCS 1980

Monument Type: Orange County Surveyor's 3 3/4"  
Aluminum Disk

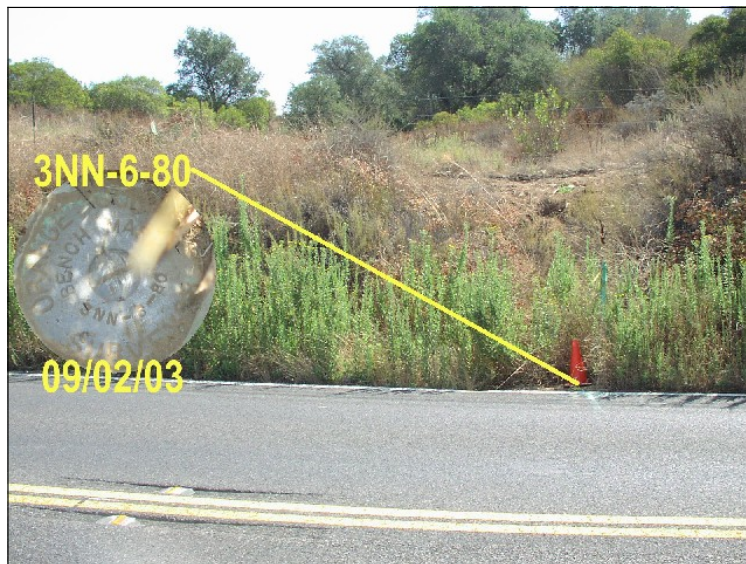

NAVD88 (ft)	NGVD29 (ft)	Year Leveled
441.510	439.175	1992

For Reconnaissance Only!	
Latitude (30' +/-)	Longitude (30' +/-)
33 32 55.19522	117 32 55.42203

### Description:

REPORTED DESTROYED (SEE DATE IN DESTROYED BOX) - ORIGINAL DESCRIPTION BEING: DESCRIBED BY OCS 2003 - FOUND 3 3/4" OCS ALUMINUM BENCHMARK DISK STAMPED "3NN-6-80", SET IN THE SOUTHERLY CORNER OF A 3 FT. BY 3.5 FT. CONCRETE DROP INLET. MONUMENT IS LOCATED ALONG THE EASTERLY SIDE OF ORTEGA HIGHWAY, 8.65 MILES EASTERLY ALONG ORTEGA FROM THE INTERSTATE 5 FREEWAY, 4 MILES SOUTHWESTERLY OF THE SAN JUAN FIRE STATION, 65.0 FT. SOUTHERLY OF A CENTERLINE POINT MARKED SECTION LINE AND WITH AN OCS PADDLEBOARD AT THE SOUTHWESTERLY SIDE OF THE INLET. MONUMENT IS SET LEVEL WITH THE TOP OF THE DROP INLET.

NO  
LOCATION  
MAP