

Designation: 3P-31-86

Date Destroyed:

Date Revised: 4/7/2004

GPS #:

OCS Index Map: Q20-06


Page/Grid: 971/G-6

City / Location: Dana Point

Line #/SSN: 400/0220

Established By: OCS 1986

Monument Type: Orange County Surveyor's 3 3/4"
Aluminum Disk

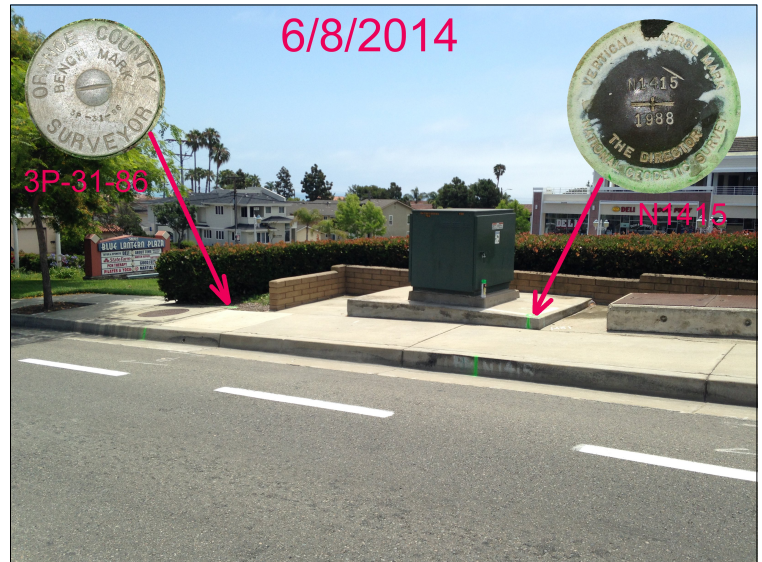

NAVD88 (ft)	NGVD29 (ft)	Year Leveled
193.947	191.644	2004
193.901	191.598	1989

For Reconnaissance Only!	
Latitude (30' +/-)	Longitude (30' +/-)
33 27 55.35	117 42 25.90

Description:

DESCRIBED BY OCS 2003 - FOUND 3 3/4" OCS ALUMINUM BENCHMARK DISK STAMPED "3P-31-86", SET IN THE SOUTHWESTERLY CORNER OF A 5.5 FT. BY 6.5 FT. CONCRETE EDISON VAULT. MONUMENT IS LOCATED IN THE SOUTHWESTERLY CORNER OF THE INTERSECTION OF PACIFIC COAST HIGHWAY AND BLUE LANTERN, 43 FT. SOUTHERLY OF THE CENTERLINE OF PCH AND 150 FT. WESTERLY OF THE CENTERLINE OF BLUE LANTERN. MONUMENT IS SET LEVEL WITH THE SIDEWALK.

