Vertical Control Data Sheet
O.C.S. 1995 Adjustment

Designation: 3PP-1-81

Date Destroyed:

Date Revised:

GPS #:

OCS Index Map: Q13-16

Page/Grid: 892/D-5

City / Location: Mission Viejo

Line #/SSN: 381/0020

Established By: OCS 1981

Monument Type: Orange County Surveyor's 3 3/4" Aluminum Disk

NAVD88 (ft)	NGVD29 (ft)	Year Leveled
730.257	727.905	1989

For Reconnaisance Only!	
Latitude (30' +/-)	Longitude (30' +/-)
33 37 40.94	117 39 05.82

Description:
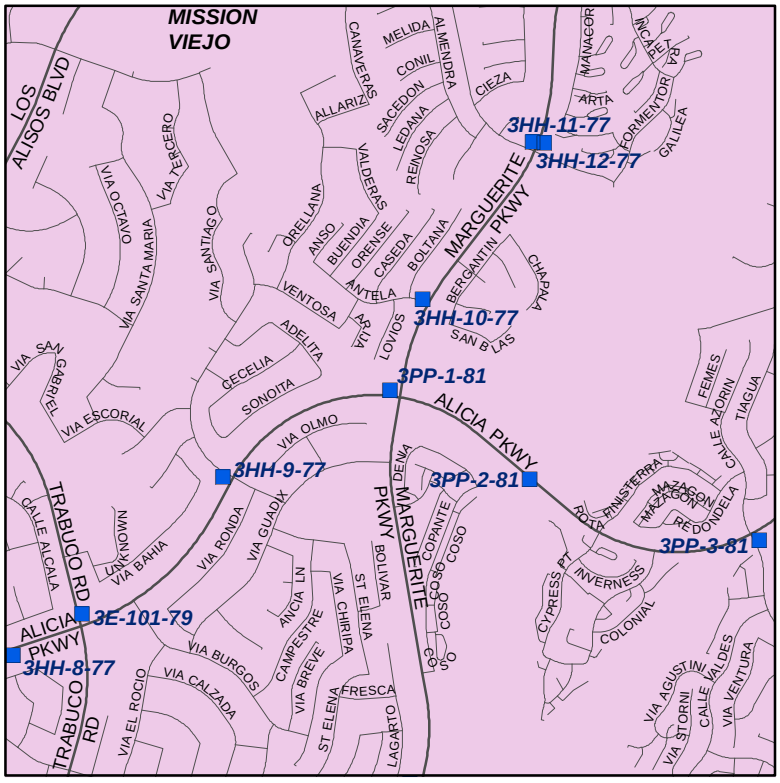
DESCRIBED BY OCS 2002 - FOUND 3 3\4" OCS ALUMINUM BENCHMARK DISK STAMPED "3PP-1-81", SET IN THE NORTHWESTERLY CORNER OF A 4.5 FT. BY 3.5 FT. CONCRETE CATCH BASIN. MONUMENT IS LOCATED IN THE NORTHWESTERLY CORNER OF THE INTERSECTION OF MARGUERITE PARKWAY AND ALICIA PARKWAY, 49.5 FT. NORTHERLY OF THE CENTER OF THE MEDIAN ALONG ALICIA AND 87.5 FT. WESTERLY OF THE CENTER MEDIAN ALONG MARGUERITE. MONUMENT IS SET LEVEL WITH THE SIDEWALK.