

Designation: 3U-31-70

Date Destroyed: 1/14/2009

Date Revised:

GPS #:

OCS Index Map: Q17-14


Page/Grid: 951/F-7

City / Location: Laguna Niguel

Line #/SSN: 368/0050

Established By: OCS 1970

Monument Type: Orange County Surveyor's 3 3/4"
Aluminum Disk

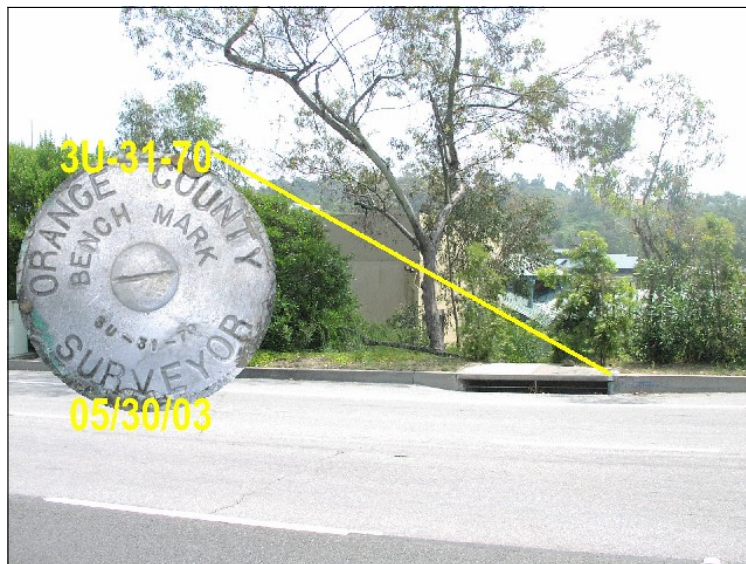

NAVD88 (ft)	NGVD29 (ft)	Year Leveled
348.613	346.291	1991

For Reconnaissance Only!	
Latitude (30' +/-)	Longitude (30' +/-)
33 30 39.91	117 43 08.96

Description:

REPORTED DESTROYED (SEE DATE IN DESTROYED BOX) - ORIGINAL DESCRIPTION BEING: DESCRIBED BY OCS 2003 - FOUND 3 3/4" OCS ALUMINUM BENCHMARK DISK STAMPED "3U-31-70", SET IN THE SOUTHWESTERLY CORNER OF A 3 FT. BY 9.5 FT. CONCRETE CATCH BASIN. MONUMENT IS LOCATED ALONG THE EASTERLY SIDE OF CROWN VALLEY PARKWAY, 415 FT. SOUTHERLY OF THE CENTERLINE OF CLUB HOUSE DRIVE AND 46 FT. EASTERLY OF THE CENTERLINE MEDIAN ALONG CROWN VALLEY. MONUMENT IS SET LEVEL WITH THE SIDEWALK.

NO
LOCATION
MAP