

## Designation: 3U-53-04

Date Destroyed:

Date Revised: 4/7/2004

GPS #:

OCS Index Map: Q17-08


Page/Grid: 922/F-6

City / Location: Ladera Ranch

Line #/SSN: 368/0200

Established By: OCS 2004

Monument Type: Orange County Surveyor's 3 3/4"  
Aluminum Disk

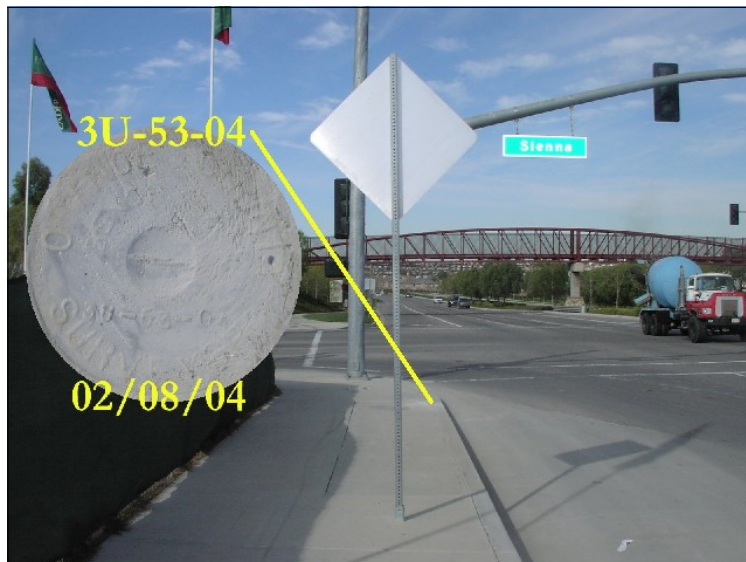

NAVD88 (ft)	NGVD29 (ft)	Year Leveled
583.200	580.862	2004

For Reconnaissance Only!	
Latitude (30' +/-)	Longitude (30' +/-)
33 33 58.11	117 37 54.75

### Description:

DESCRIBED BY OCS 2004 - FOUND 3 3/4" OCS ALUMINUM BENCHMARK DISK STAMPED "3U-53-04", SET IN THE NORTHWESTERLY CORNER OF A 5 FT. BY 20 FT. CONCRETE CATCH BASIN. MONUMENT IS LOCATED IN THE SOUTHEASTERLY CORNER OF THE INTERSECTION OF CROWN VALLEY PARKWAY AND SIENNA PARKWAY, 58 FT. SOUTHERLY OF THE CENTERLINE OF CROWN VALLEY AND 82 FT. EASTERLY OF THE CENTERLINE OF SIENNA. MONUMENT IS SET LEVEL WITH THE SIDEWALK.

