

Designation: 3V-8-80

Date Destroyed:

Date Revised:

GPS #:

OCS Index Map: Q14-01


Page/Grid: 832/J-2

City / Location: Silverado Canyon

Line #/SSN: 369/0100

Established By: OCS 1980

Monument Type: Orange County Surveyor's 3 3/4"
Aluminum Disk

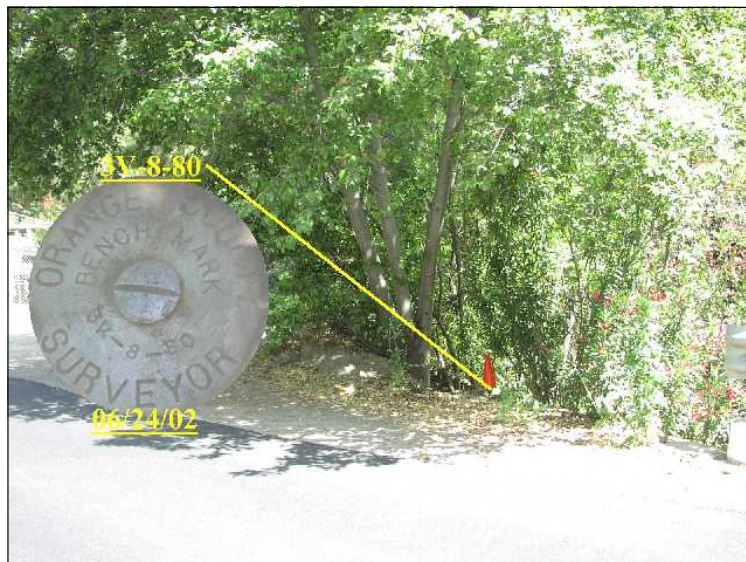

NAVD88 (ft)	NGVD29 (ft)	Year Leveled
1534.095	1531.705	1992

For Reconnaissance Only!	
Latitude (30' +/-)	Longitude (30' +/-)
33 44 45.92	117 36 20.63

Description:

DESCRIBED BY OCS 2003 - FOUND 3 3/4" OCS ALUMINUM BENCHMARK DISK STAMPED "3V-8-80", SET IN THE SOUTHEASTERLY END OF THE SOUTHERLY WINGWALL FOR A CONCRETE BRIDGE #SV-11. MONUMENT IS LOCATED IN THE SOUTHEASTERLY CORNER OF THE INTERSECTION OF SILVERADO CANYON ROAD AND A SMALL CREEK CROSSING, 23 FT. SOUTHERLY OF THE CENTERLINE OF SILVERADO AND 4.15 MILES EASTERLY ALONG SILVERADO FROM THE CENTERLINE OF BLACK STAR CANYON ROAD. MONUMENT IS SET LEVEL WITH THE TOP OF THE WINGWALL.

