Vertical Control Data Sheet
O.C.S. 1995 Adjustment

Designation: 3Y-37-91

Date Destroyed:
Date Revised: 6/14/2005
GPS #:
OCS Index Map: Q21-05
Page/Grid: 993/A-1
City / Location: San Clemente

Line #/SSN: 372/0050
Established By: OCS 1991
Monument Type: Orange County Surveyor's 3 3/4" Aluminum Disk

NAVD88 (ft)	NGVD29 (ft)	Year Leveled
233.869	231.540	2005
233.788	231.489	1991

For Reconnaisance Only!	
Latitude (30' +/-)	Longitude (30' +/-)
33 26 59.52	117 36 31.95
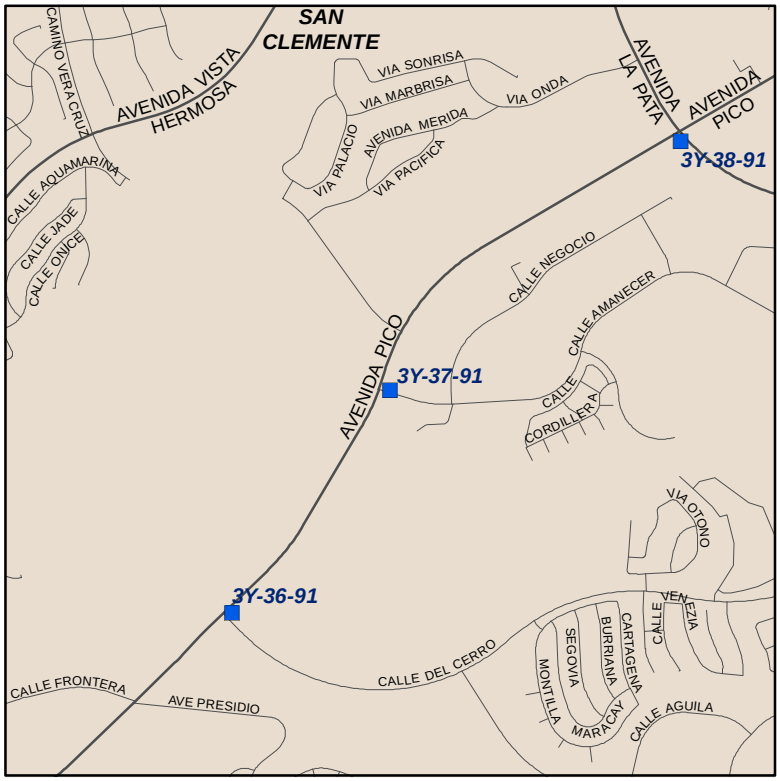
Description:
DESCRIBED BY OCS 2003 - FOUND 3 3\4" OCS ALUMINUM BENCHMARK DISK STAMPED "3Y-37-91", SET IN THE SOUTHWESTERLY CORNER OF A 4 FT. BY 8 FT. CONCRETE CATCH BASIN. MONUMENT IS LOCATED IN THE NORTHEASTERLY CORNER OF THE INTERSECTION OF AVENIDA PICO AND CALLE AMANACER, 30 FT. NORTHERLY OF THE CENTERLINE OF CALLE AMANACER AND 110 FT. EASTERLY OF THE CENTERLINE OF AVENIDA PICO. MONUMENT IS SET LEVEL WITH THE SIDEWALK.