OC Public Works
OC Survey

Vertical Control Data Sheet
O.C.S. 1995 Adjustment

Designation: 3Y-38-91

Date Destroyed:
Date Revised:
GPS #: 1482
OCS Index Map: Q21-05
Page/Grid: 973/B-7
City / Location: San Clemente

Line #/SSN: 372/0060
Established By: OCS 1991
Monument Type: Orange County Surveyor's 3 3/4" Aluminum Disk

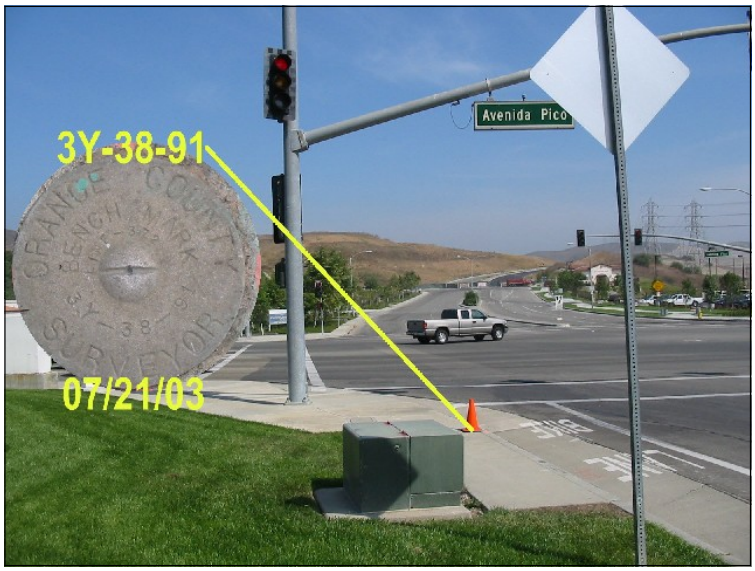

NAVD88 (ft)	NGVD29 (ft)	Year Leveled
252.197	249.897	2005
252.197	249.897	1991

For Reconnaisance Only!	
Latitude (30' +/-)	Longitude (30' +/-)
33 27 21.29904	117 36 02.38467

Description:
DESCRIBED BY OCS 2003 - FOUND 3 3\4" OCS ALUMINUM BENCHMARK DISK STAMPED "3Y-38-91", SET IN THE NORTHWESTERLY CORNER OF A 4 FT. BY 17 FT. CONCRETE CATCH BASIN. MONUMENT IS LOCATED IN THE SOUTHEASTERLY CORNER OF THE INTERSECTION OF AVENIDA PICO AND AVENIDA LA PATA, 50 FT. SOUTHERLY OF THE CENTERLINE OF AVENIDA LA PATA AND 90 FT. EASTERLY OF AVENIDA PICO. MONUMENT IS SET LEVEL WITH THE TOP OF THE CURB.

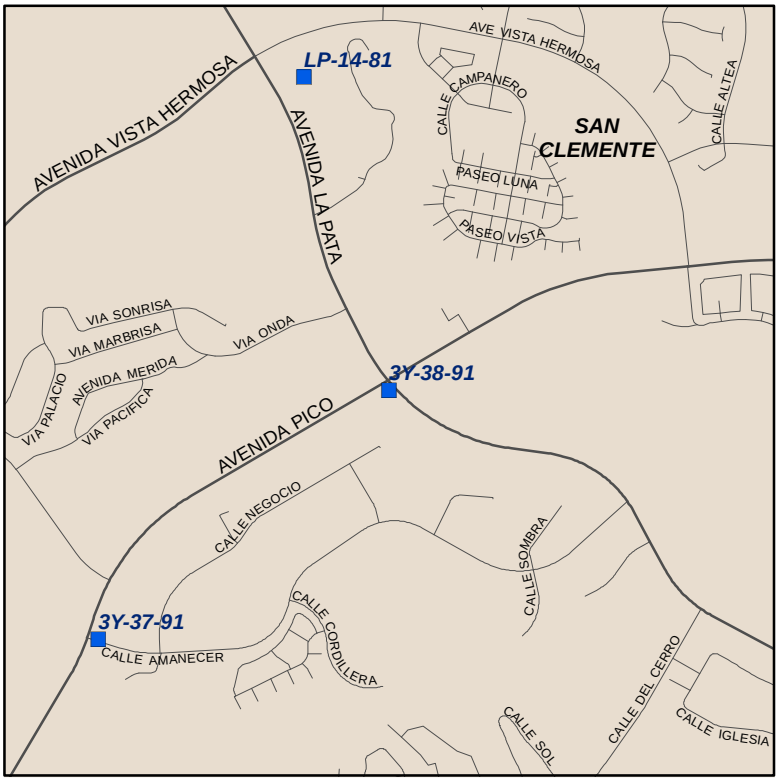

Benchmarks may have more than one height due to the datum, adjustments, and year leveled. To avoid confusion, always state these as references when using Benchmark elevation values.