

Designation: 404-11-68

Date Destroyed:

Date Revised:

GPS #:

OCS Index Map: Q06-03


Page/Grid: 738/J-7

City / Location: Fullerton

Line #/SSN: 404/0110

Established By: OCS 1968

Monument Type: Orange County Surveyor's 3 3/4"
Aluminum Disk

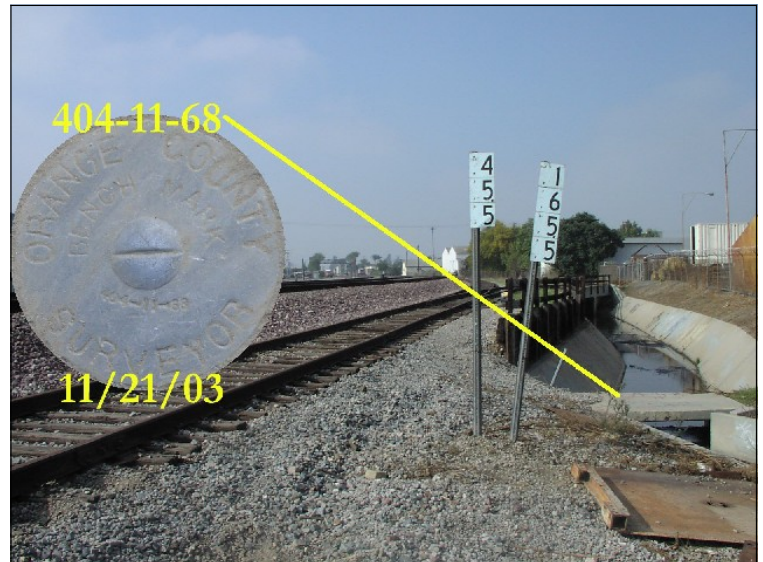

NAVD88 (ft)	NGVD29 (ft)	Year Leveled
161.460	159.035	1990

For Reconnaissance Only!	
Latitude (30' +/-)	Longitude (30' +/-)
33 52 06.79	117 54 56.26

Description:

DESCRIBED BY OCS 2003 - FOUND 3 3/4" OCS ALUMINUM BENCHMARK DISK STAMPED "404-11-68", SET IN THE SOUTHWESTERLY CORNER OF A 6 FT. BY 7 FT. CONCRETE SLAB. MONUMENT IS LOCATED IN THE NORTHERLY PORTION OF THE INTERSECTION OF THE ATCHINSON TOPEKA SANTA FE RAILWAY AND NORTH BALCOM AVENUE, 41 FT. WESTERLY OF THE EXTENDED CENTERLINE OF BALCOM TO THE SOUTH AND 12 FT. NORTHERLY OF THE NORTHERLY RAIL ALONG THE RAILWAY. MONUMENT IS SET 2.5 FT. BELOW THE LEVEL OF THE RAILWAY.

