

Designation: 404-28-05

Date Destroyed:

Date Revised: 8/25/2005

GPS #:

OCS Index Map: Q06-02


Page/Grid: 738/E-7

City / Location: Fullerton

Line #/SSN: 404/0250

Established By: OCS 2005

Monument Type: Orange County Surveyor's 3 3/4"
Aluminum Disk

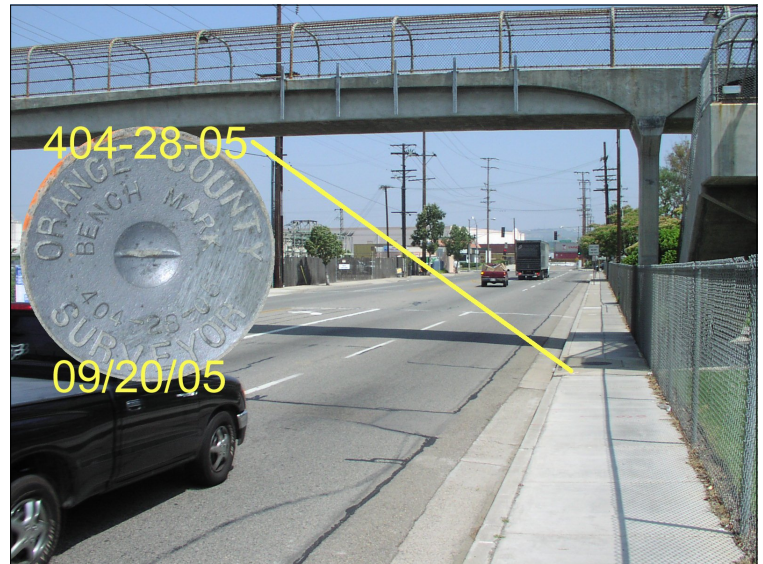

NAVD88 (ft)	NGVD29 (ft)	Year Levelled
111.261	108.838	2005

For Reconnaissance Only!	
Latitude (30' +/-)	Longitude (30' +/-)
33 52 07.76	117 57 33.50

Description:

DESCRIBED BY OCS 2005 - FOUND 3 3/4" OCS ALUMINUM BENCHMARK DISK STAMPED "404-28-05", SET IN THE SOUTHWESTERLY CORNER OF A 4 FT. BY 12 FT. CONCRETE CATCH BASIN. MONUMENT IS LOCATED ALONG THE EASTERLY SIDE OF THE BROOKHURST STREET, 450 FT. SOUTHERLY OF THE CENTERLINE OF COMMONWEALTH AVENUE AND 33 FT. EASTERLY OF THE CENTERLINE OF BROOKHURST. MONUMENT IS SET LEVEL WITH THE SIDEWALK

