Vertical Control Data Sheet
O.C.S. 1995 Adjustment

Designation: 404-30-05

Date Destroyed:
Date Revised: 8/25/2005
GPS #:
OCS Index Map: Q06-03
Page/Grid: 738/G-7
City / Location: Fullerton

Line #/SSN: 404/0270
Established By: OCS 2005
Monument Type: Orange County Surveyor's 3 3/4" Aluminum Disk

NAVD88 (ft)	NGVD29 (ft)	Year Leveled
145.349	142.927	2005

For Reconnaisance Only!	
Latitude (30' +/-)	Longitude (30' +/-)
33 52 05.41	117 55 59.29
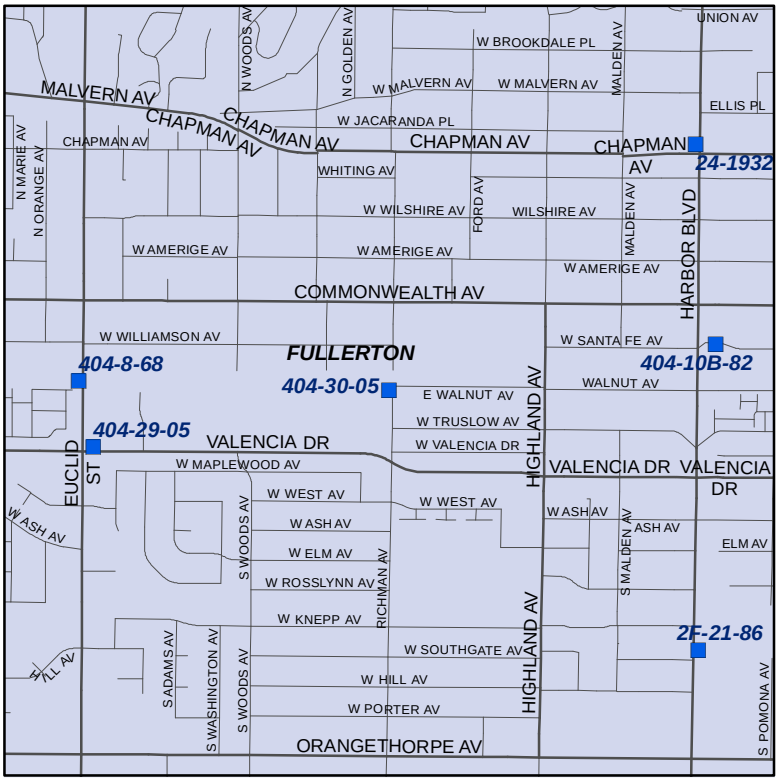
Description:
DESCRIBED BY OCS 2005 - FOUND 3 3\4" OCS ALUMINUM BENCHMARK DISK STAMPED "404-30-05", SET IN THE NORTHEASTERLY CORNER OF AN 8.0 FT. BY 3.4 FT. CONCRETE CATCH BASIN. MONUMENT IS LOCATED IN THE SOUTHWESTERLY CORNER OF THE INTERSECTION OF RICHMAN AVENUE AND WALNUT AVENUE, 32 FT. WESTERLY OF THE CENTERLINE OF RICHMAN AND 100 FT. SOUTHERLY OF THE CENTERLINE OF WALNUT. MONUMENT IS SET LEVEL WITH THE SIDEWALK