

Designation: CM-30-81

Date Destroyed:

Date Revised: 5/5/2004

GPS #:

OCS Index Map: Q11-08


Page/Grid: 859/E-3

City / Location: Santa Ana

Line #/SSN: 561/0040

Established By: OCS 1981

Monument Type: Orange County Surveyor's 3 3/4"
Aluminum Disk

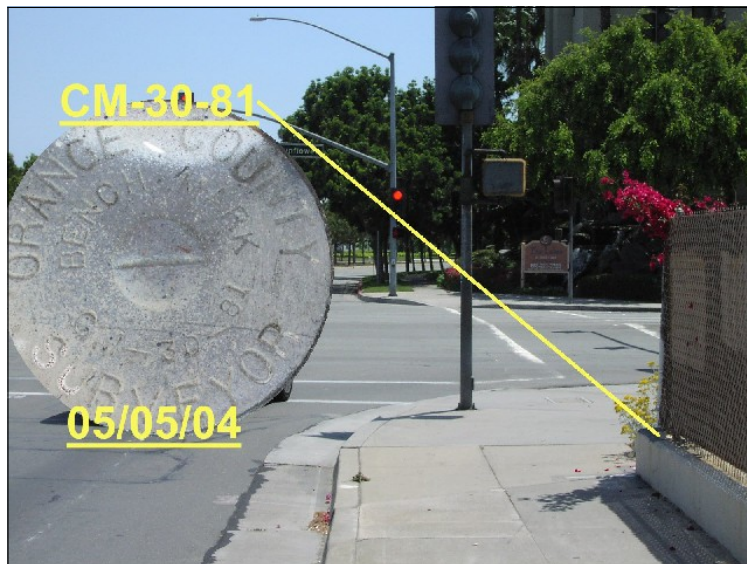

NAVD88 (ft)	NGVD29 (ft)	Year Leveled
35.282	32.878	2010
35.472	33.056	1992

For Reconnaissance Only!	
Latitude (30' +/-)	Longitude (30' +/-)
33 41 39.85	117 52 37.67

Description:

DESCRIBED BY OCS 2004 - FOUND 3 3/4" OCS ALUMINUM BENCHMARK DISK STAMPED "CM-30-81", SET IN THE TOP SOUTHERLY END OF A 1 FT. BY 20 FT. LONG CONCRETE HEADWALL FOR A FLOOD CONTROL CHANNEL. MONUMENT IS LOCATED IN THE NORTHWESTERLY CORNER OF THE INTERSECTION OF FLOWER STREET AND SUNFLOWER AVENUE, 42 FT. NORTHERLY OF THE NORTHERLY CURB ALONG SUNFLOWER AND 32 FT. WESTERLY OF THE CENTERLINE OF FLOWER. MONUMENT IS SET LEVEL WITH THE SIDEWALK

