

Designation: CM-43-81

Date Destroyed:

Date Revised:

GPS #:

OCS Index Map: Q11-08


Page/Grid: 859/B-3

City / Location: Santa Ana

Line #/SSN: 561/0020

Established By: OCS 1981

Monument Type: Orange County Surveyor's 3 3/4"
Aluminum Disk

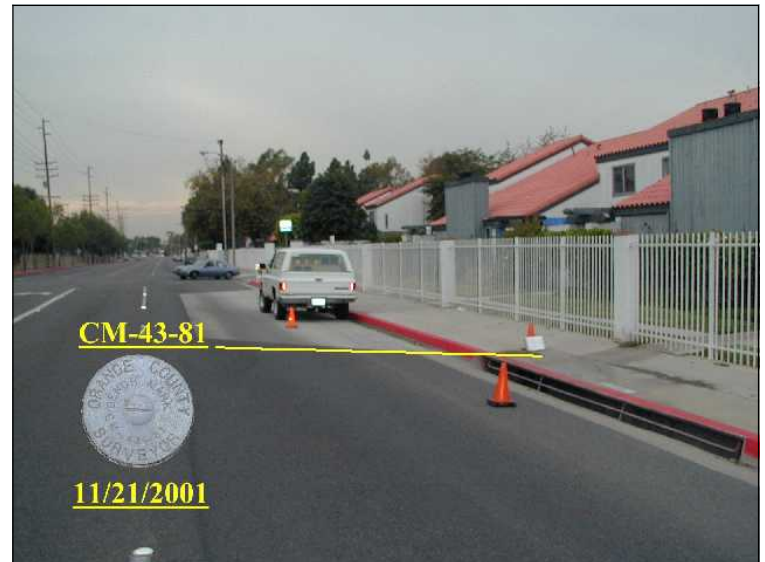

NAVD88 (ft)	NGVD29 (ft)	Year Leveled
32.981	30.579	2010
33.172	30.754	1989

For Reconnaissance Only!	
Latitude (30' +/-)	Longitude (30' +/-)
33 41 47.05	117 54 01.78

Description:

DESCRIBED BY OCS 2001 - FOUND 3 3/4" OCS ALUMINUM BENCHMARK DISK STAMPED "CM-43-81", SET IN A 21FT. BY 4FT. CONCRETE CATCH BASIN. MONUMENT IS LOCATED ALONG THE NORTH SIDE OF SUNFLOWER AVENUE, 123FT. EASTERLY OF THE CENTERLINE PROLONGATION OF SMALLEY ROAD. MONUMENT IS SET LEVEL WITH THE SIDEWALK.

