

Designation: F-582

Date Destroyed:

Date Revised: 11/29/1999

GPS #:

OCS Index Map: Q08-13


Page/Grid: 801/B-5

City / Location: Unin., Orange Co.

Line #/SSN: 354/0380

Established By: USC & GS 1939

Monument Type: Bronze / Brass Disk

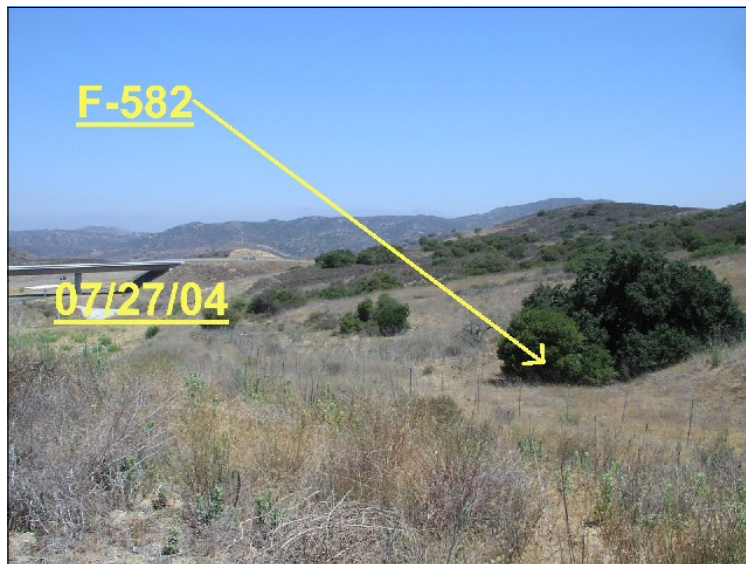

NAVD88 (ft)	NGVD29 (ft)	Year Leveled
792.780	790.368	1999
792.852	790.439	1991

For Reconnaissance Only!	
Latitude (30' +/-)	Longitude (30' +/-)
33 46 46.37	117 44 47.73

Description:

DESCRIBED BY OCS 2004 - FOUND 3 3/4" USC&GS BRONZED DISK STAMPED "F 582 1939", SET IN THE TOP OF A CONCRETE POST. MONUMENT IS LOCATED ALONG THE NORTHEASTERLY SIDE OF SANTIAGO CANYON ROAD, 1.65 MILES SOUTHEASTERLY ALONG SANTIAGO CANYON FROM THEIR CENTERLINE OF JAMBOREE ROAD, 230 FT. NORTHEASTERLY

