Vertical Control Data Sheet
O.C.S. 1995 Adjustment

Designation: FV-57-70

Date Destroyed:

Date Revised:

GPS #:

OCS Index Map: Q11-06

Page/Grid: 858/E-1

City / Location: Fountain Valley

Line #/SSN: 606/0040

Established By: OCS 1970

Monument Type: Orange County Surveyor's 3 3/4" Aluminum Disk

NAVD88 (ft)	NGVD29 (ft)	Year Leveled
29.945	27.533	2010
30.125	27.700	1992

For Reconnaisance Only!	
Latitude (30' +/-)	Longitude (30' +/-)
33 42 33.68	117 57 15.24

Description:
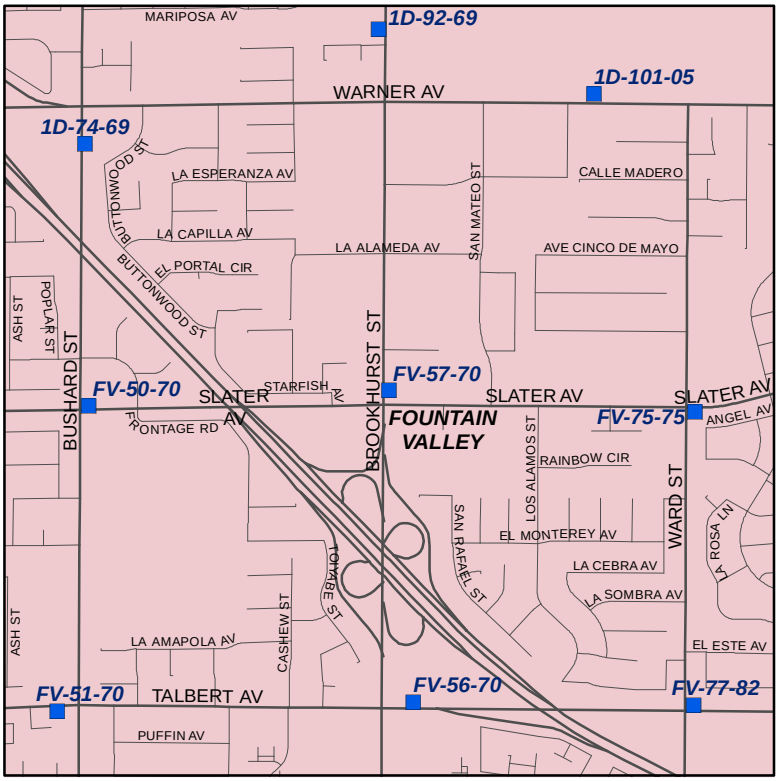
DESCRIBED BY OCS 2002 - FOUND 3 3\4" OCS ALUMINUM BENCHMARK DISK STAMPED "FV-57-70", SET IN THE NORTHWEST CORNER OF A 5 FT. BY 5.5 FT. CONCRETE CATCH BASIN. MONUMENT IS LOCATED IN THE NORTHEAST CORNER OF THE INTERSECTION OF BROOKHURST STREET AND SLATER AVENUE, 46 FT. EASTERLY OF THE CENTERLINE OF THE MEDIAN ALONG BROOKHURST STREET AND 84.5 FT. NORTHERLY OF THE PROLONGATION OF THE NORTH CURB ALONG SLATER. MONUMENT IS SET LEVEL WITH THE SIDEWALK.