

Designation: FV-59-70

Date Destroyed:

Date Revised:

GPS #:

OCS Index Map: Q11-02


Page/Grid: 828/E-5

City / Location: Fountain Valley

Line #/SSN: 600/0040

Established By: OCS 1970

Monument Type: Orange County Surveyor's 3 3/4"
Aluminum Disk

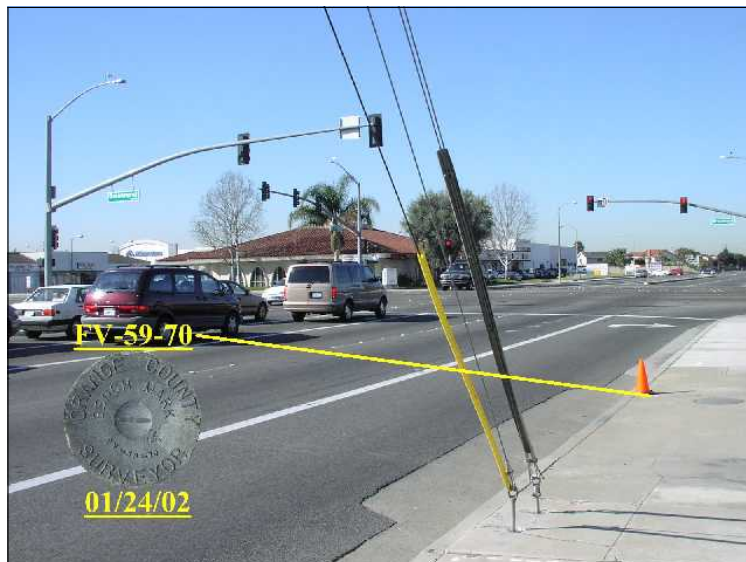

NAVD88 (ft)	NGVD29 (ft)	Year Leveled
41.929	39.515	2005
42.071	39.637	1992

For Reconnaissance Only!	
Latitude (30' +/-)	Longitude (30' +/-)
33 43 49.97	117 57 15.08

Description:

DESCRIBED BY OCS 2002 - FOUND 3 3/4" OCS ALUMINUM BENCHMARK DISK STAMPED "FV-59-70", SET IN THE SOUTHEAST CORNER OF A 5 FT. BY 10 FT. CONCRETE CATCH BASIN. MONUMENT IS LOCATED IN THE NORTHEAST CORNER OF THE INTERSECTION OF EDINGER AVENUE AND BROOKHURST STREET, 42.5 FT. NORTHERLY OF THE CENTERLINE OF EDINGER AVENUE AND 90.5 FT. EASTERLY OF THE PROLONGATION OF THE EAST CURB FACE ALONG BROOKHURST. MONUMENT IS SET LEVEL WITH THE SIDEWALK.

