

Designation: GG-154

Date Destroyed:

Date Revised:

GPS #:

OCS Index Map:


Page/Grid: 828/F4

City / Location: Garden Grove

Line #/SSN:

Established By: KDM Survey 2012

Monument Type: Bronze / Brass Disk

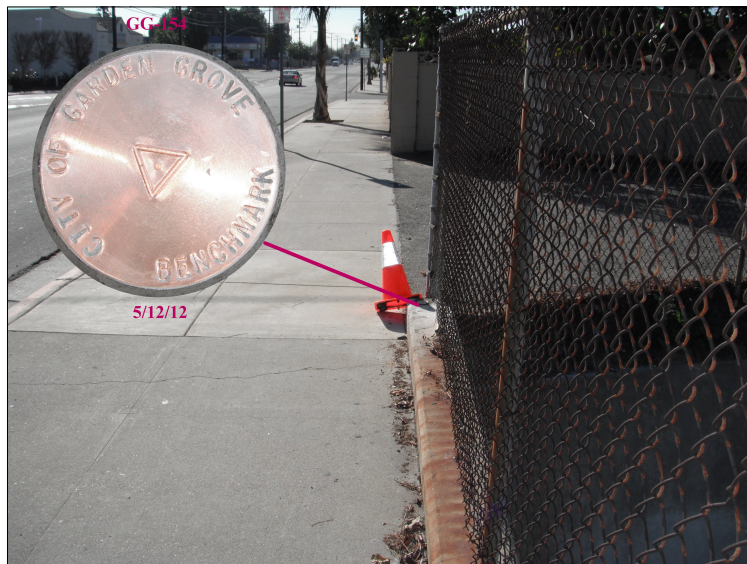

NAVD88 (ft)	NGVD29 (ft)	Year Leveled
50.512	48.094	2012

For Reconnaissance Only!	
Latitude (30' +/-)	Longitude (30' +/-)
33 44 20.64948	117 56 46.37796

Description:

FOUND 2 ½" BRONZE CITY OF GARDEN GROVE BENCHMARK DISK WITH PUNCH IN TRIANGLE, SET IN THE TOP OF HEADWALL OF FLOOD CONTROL CHANNEL. MONUMENT IS LOCATED IN THE NORTHWEST QUADRANT OF THE INTERSECTION OF NOTTINGHAM AVE. AND WARD ST. 113 FT. NORTH OF THE B.C.R. AND 8 FT. WEST OF THE CURB FACE.

