

Designation: HB-180-71

Date Destroyed:

Date Revised:

GPS #: 1542

OCS Index Map: Q11-10


Page/Grid: 858/D-5

City / Location: Huntington Beach

Line #/SSN: 638/0030

Established By: OCS 1971

Monument Type: Orange County Surveyor's 3 3/4"
Aluminum Disk

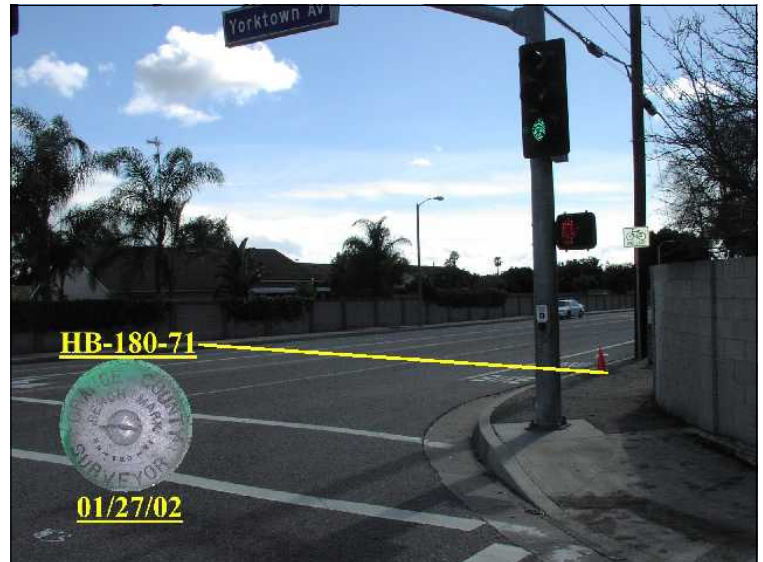

NAVD88 (ft)	NGVD29 (ft)	Year Levelled
13.152	10.739	2005
13.341	10.923	1992

For Reconnaissance Only!	
Latitude (30' +/-)	Longitude (30' +/-)
33 40 45.65738	117 57 45.89159

Description:

DESCRIBED BY OCS 2002 - FOUND 3 3/4" OCS ALUMINUM BENCHMARK DISK STAMPED "HB-180-71", SET IN THE TOP OF A 6 IN. BY 6 IN. CONCRETE POST. MONUMENT IS LOCATED IN THE SOUTHWEST CORNER OF THE INTERSECTION OF YORKTOWN AVENUE AND BUSHARD STREET, 33.5 FT. WESTERLY OF THE CENTERLINE OF BUSHARD AND 71 FT. SOUTHERLY OF THE CENTERLINE OF YORKTOWN AVENUE. MONUMENT IS SET LEVEL WITH THE SIDEWALK.

