

Designation: HB-220-72

Date Destroyed:

Date Revised:

GPS #:

OCS Index Map: Q10-04


Page/Grid: 827/H-6

City / Location: Huntington Beach

Line #/SSN: 628/0040

Established By: OCS 1972

Monument Type: Orange County Surveyor's 3 3/4"
Aluminum Disk

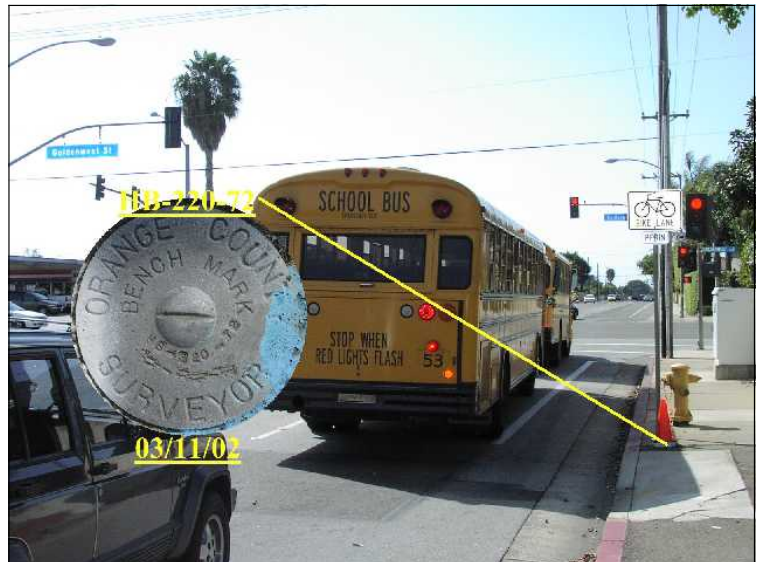

NAVD88 (ft)	NGVD29 (ft)	Year Leveled
14.323	11.907	2005
14.613	12.180	1992

For Reconnaissance Only!	
Latitude (30' +/-)	Longitude (30' +/-)
33 43 22.47	118 00 22.35

Description:

DESCRIBED BY OCS 2002 - FOUND 3 3/4" OCS ALUMINUM BENCHMARK DISK STAMPED "HB-220-72", SET IN THE TOP OF A 6 IN. BY 6 IN. CONCRETE POST. MONUMENT IS LOCATED IN THE NORTHEAST CORNER OF THE INTERSECTION OF HEIL AVENUE AND GOLDENWEST STREET, 33 FT. NORTHERLY OF THE CENTERLINE OF HEIL AVENUE AND 1 FT. NORTH OF THE NORTH CURB ALONG HEIL. MONUMENT IS SET LEVEL WITH THE SIDEWALK.

