

Designation: HB-235-75

Date Destroyed:

Date Revised:

GPS #:

OCS Index Map: Q10-03


Page/Grid: 827/D-6

City / Location: Huntington Beach

Line #/SSN: 626/0070

Established By: OCS 1975

Monument Type: Orange County Surveyor's 3 3/4"
Aluminum Disk

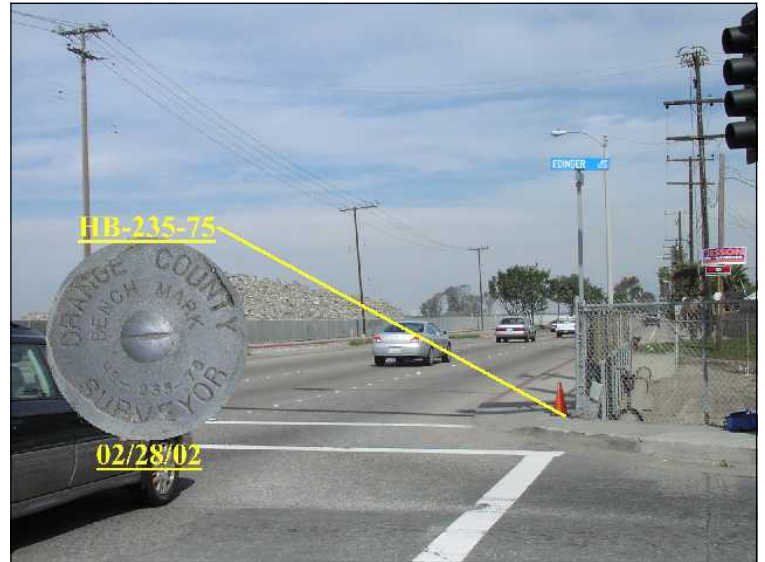

NAVD88 (ft)	NGVD29 (ft)	Year Leveled
15.512	13.096	2005
15.650	13.212	1992

For Reconnaissance Only!	
Latitude (30' +/-)	Longitude (30' +/-)
33 43 47.89	118 02 29.10

Description:

DESCRIBED BY OCS 2002 - FOUND 3 3/4" OCS ALUMINUM BENCHMARK DISK STAMPED "HB-235-75", SET IN THE TOP OF A CONCRETE BRIDGE DECK. MONUMENT IS LOCATED IN THE NORTHEAST CORNER OF THE INTERSECTION OF EDINGER AVENUE AND BOLSA CHICA STREET, 41 FT. NORTHERLY OF THE CENTERLINE OF EDINGER AVENUE AND 49 FT. EASTERLY OF THE CENTERLINE OF BOLSA CHICA STREET. MONUMENT IS SET LEVEL WITH THE BRIDGE DECK.

