

## Designation: LP-11-81

Date Destroyed:

Date Revised: 1/22/2014

GPS #:

OCS Index Map: Q21-01


Page/Grid: 973/A-5

City / Location: San Clemente

Line #/SSN: 380/0050

Established By: OCS 1981

Monument Type: Orange County Surveyor's 3 3/4"  
Aluminum Disk

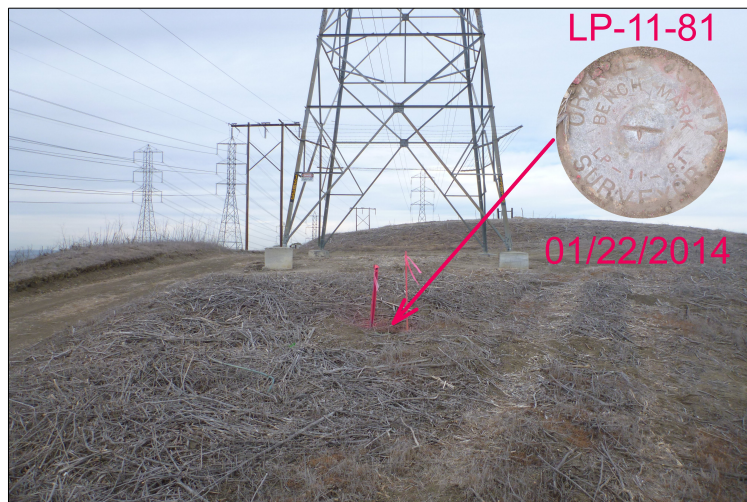

NAVD88 (ft)	NGVD29 (ft)	Year Leveled
747.077	744.774	1991

For Reconnaissance Only!	
Latitude (30' +/-)	Longitude (30' +/-)
33 28 43.03956	117 36 33.36644

### Description:

DESCRIBED BY OCS 2014 - FOUND 3 3/4" OCS ALUMINUM BENCHMARK DISK STAMPED "LP-11-81" SET IN CONCRETE POST, DOWN 0.3' IN GROUND. BENCHMARK IS LOCATED 25' +/- SOUTHERLY FROM THE SOUTHERLY EDGE OF A TRANSMISSION TOWER.

